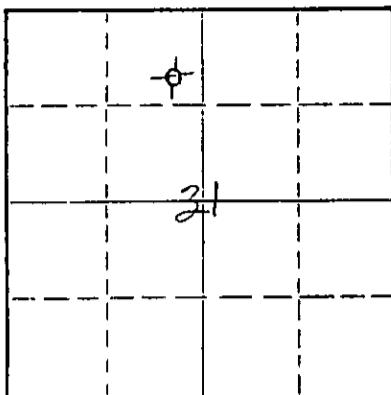


STATE OF KANSAS
STATE CORPORATION COMMISSION

Give All Information Completely
Make Required Affidavit
Mail or Deliver Report to:
 Conservation Division
 State Corporation Commission
 212 No. Market
 Wichita, Kansas

NORTH



Locate well correctly on above
Section Plat

WELL PLUGGING RECORD

Saline County. Sec. 31 Twp. 15 Rge. 1 (EXX) (W)
Location as "NE/CNW&SW&" or footage from lines SE/4 NE/4 NW/4
Lease Owner Dale Reese Oil Company
Lease Name Peterson Well No. 2
Office Address 415 E. Prescott, Salina, Kansas 67401
Character of Well (completed as Oil, Gas or Dry Hole) Dry
Date well completed February 6, 19 70
Application for plugging filed 19
Application for plugging approved 19
Plugging commenced 19
Plugging completed February 6, 19 70
Reason for abandonment of well or producing formation Dry Hole
If a producing well is abandoned, date of last production 19

Locate well correctly on above
Section Plat _____ Was permission obtained from the Conservation Division or its agents before plugging was com-
menced? _____ Yes _____

OIL, GAS OR WATER RECORDS

CASING RECORD

Describe in detail the manner in which the well was plugged, indicating where the mud fluid was placed and the method or methods used in introducing it into the hole. If cement or other plugs were used, state the character of same and depth placed, from _____ feet to _____ feet for each plug set.

Set 1st. plug at 105 ft. and put in 25 sacks of cement.
Set 2nd plug at 40' and put in 10 sacks of cement, 2
sacks in rat hole. Plug down at 1:30 P. M., February 6,
1970. Plugging completed by state plugger, Gilbert
Toman, Holyrood, Kansas.

(If additional description is necessary, use BACK of this sheet)
Name of Plugging Contractor BLACKSTONE DRILLING, INC.
Address Box 455, McPherson, Kansas 67460

STATE OF Kansas, COUNTY OF Saline, ss.
Dale Reese (Employee or owner, or operator) of the above-described
well, being first duly sworn on oath, says: That I have knowledge of the facts, statements, and matters herein contained and the log of the
above-described well as filed and that the same are true and correct. So help me God.

(Signature) *Pete Rees*

415 E. Prescott, Salina, Kansas
(Address)

SUBSCRIBED AND SWEARN TO before me this 13 day of February, 19 70

My commission expires Jan. 7, 1973

Jan. 7, 1973

Notary Public.



15-169-20035-0000

Blackstone Drilling, Inc.

Box 455 • 523 West Kansas • Phone CH 1-1250

McPHERSON, KANSAS 67460

February 10, 1970

COMPANY: DALE REESE OIL COMPANY

CONTRACTOR: BLACKSTONE DRILLING, INC.

FARM: PETERSON #2

LOCATION: SE/4 NE/4 NW/4, Sec. 31-15-1W,
Saline County, Kansas

COMMENCED: February 2, 1970

COMPLETED: February 6, 1970

ELEVATION: 1305 K. B.

0	to	225	Lime
225	to	550	Lime & Shale
550	to	850	Lime
850	to	1615	Shale & Lime
1615	to	1870	Lime & Shale
1870	to	2064	Shale & Sand
2064	to	2150	Kansas City
2150	to	2530	Lime
2530	to	2695	Lime & Shale
2695	to	2684	Lime
2684	to	2714	Mississippi
		2714	T. D.

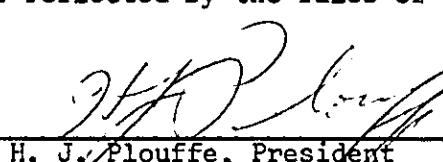
Cut 12 1/4 in. hole to 112 ft. and run 115 ft. of 8 5/8 in. surface pipe, cemented with 115 sacks of cement at 112 ft., plug down at 3:00 P. M., February 2, 1970. Cut 7 7/8 in. hole to 2714 ft. Dry and abandoned. Set first plug at 105 ft. and filled with 25 sacks of cement. Set 2nd. plug at 40 ft. and put in 10 sacks of cement. Put 2 sacks of cement in rathole. Plugging completed at 1:30 P. M., February 6, 1970. Plugging composed by State Plugger, Gilbert Toman, Holyrood, Kansas.

TOPS: BROWN LIME - 2001' LANSING - 2064' MISSISSIPPI - 2684'

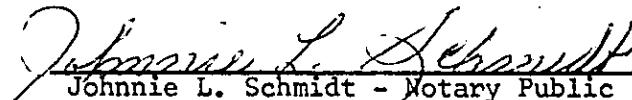
Measurements taken from K. B.

CERTIFICATE

I, H. J. Plouffe, President of Blackstone Drilling, Inc. do hereby certify that the above and foregoing is a true and correct copy of log on your Peterson #2, located on the SE/4 NE/4 NW/4, Sec. 31-15-1W, Saline County as reflected by the files of Blackstone Drilling, Inc.


H. J. Plouffe, President

Subscribed and sworn to before me a Notary Public in and for McPherson County, Kansas this 10 day of February, 1970.


Johnnie L. Schmidt - Notary Public

My Commission Expires: June 27, 1973.

