


WELL PLUGGING RECORD

Give All Information Completely  
Make Required Affidavit  
Mail or Deliver Report to:  
Conservation Division  
State Corporation Commission  
211 No. Broadway  
Wichita, Kansas

McPherson County. Sec. 31 Twp. 15 Rge. 1 ~~XX~~ (W)

NORTH

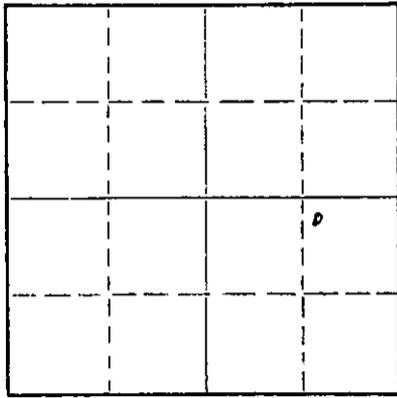

Locate well correctly on above Section Plat

Location as "NE/CNW&SW&" or footage from lines \_\_\_\_\_  
Lease Owner George R. Hess  
Lease Name George R. Hess Well No. 1  
Office Address McPherson, Kansas  
Character of Well (completed as Oil, Gas or Dry Hole) Dry Hole  
Date well completed August 25, 19 58  
Application for plugging filed August 25, 19 58  
Application for plugging approved August 25, 19 58  
Plugging commenced August 25, 19 58  
Plugging completed August 25, 19 58  
Reason for abandonment of well or producing formation Dry

If a producing well is abandoned, date of last production \_\_\_\_\_ 19\_\_\_\_  
Was permission obtained from the Conservation Division or its agents before plugging was commenced? yes

Name of Conservation Agent who supervised plugging of this well Mallard Drilling Company  
Producing formation Mississippi Depth to top 2704 Bottom 2770 Total Depth of Well 2770 Feet  
Show depth and thickness of all water, oil and gas formations.

OIL, GAS OR WATER RECORDS

CASING RECORD

FORMATION	CONTENT	FROM	TO	SIZE	PUT IN	PULLED OUT
Soil Shale & Shells	none	0	166	8 5/8	166'	none.

Describe in detail the manner in which the well was plugged, indicating where the mud fluid was placed and the method or methods used in introducing it into the hole. If cement or other plugs were used, state the character of same and depth placed, from \_\_\_\_\_ feet to \_\_\_\_\_ feet for each plug set.

Filled with heavy mud to 166' and hole bridged and spotted thru drill pipe with 20 sacks of cement. Filled with heavy mud to 10' finished filling with cement (as per orders from plugger).

SEP 19 1958  
CONSERVATION DIVISION  
Wichita, Kansas

(If additional description is necessary, use BACK of this sheet)

Name of Plugging Contractor Mallard Drilling Company  
Address Wichita, Kansas

STATE OF Kansas COUNTY OF McPherson, ss.  
George R. Hess (~~employee of owner~~) or (owner or operator) of the above-described

well, being first duly sworn on oath, says: That I have knowledge of the facts, statements, and matters herein contained and the log of the above-described well as filed and that the same are true and correct. So help me God.

(Signature) George R. Hess

SUBSCRIBED AND SWORN TO before me this 17 day of September, 19 58.

My commission expires January 17, 1961 Charles R. H. ... Notary Public.

PLUGGING  
FILE SEC 31 T 15 R 1W  
BOOK PAGE 27 LINE 10

15169.00053.0000

COMPANY: George Hess  
 CONTRACTOR: Mallard Drilling Company  
 FARM: George Hess #1  
 LOCATION: NW NE NE Sec. 31-15-1W  
 Saline County, Kansas  
 COMMENCED: August 18, 1958  
 COMPLETED: August 25, 1958

0	to	75	Shale and sand
75	to	166	Shale
166	to	380	Line
380	to	765	Line
765	to	1580	Shale and lime
1580	to	2077	Shale and lime
2077	to	2095	Lime
2095	to	2435	Lime
2435	to	2725	Lime and shale
2725	to	2770	Mississippi
		2770	T.D. Rotary

Set 166 feet of 8 5/8" surface pipe. Cemented with 100 sacks cement.

TOPS: Brown line -- 2014 Kansas City -- 2077 Top chat-- 2704  
Elevation- 1330

DRY, ABANDONED AND PLUGGED

C E R T I F I C A T E

I, C. C. Nelson, do hereby certify that the above and foregoing is a true and correct copy of log of the George Hess #1, Saline County, Kansas, as reflected by files of the Mallard Drilling Company.

*C. C. Nelson*

Subscribed and sworn to before me a Notary Public, within and for Sedgwick County, Kansas, this 13<sup>th</sup> day of September 1958.

*Edward J. Saef*

My commission expires March 12, 1962

*P.S.T. top of lime run. 15ft  
Heavy mud few spots of sand  
Lime oil B.H.P. 490# did  
still increasing*

*Lime was 100%  
Soluble in acid.*

*8-17-58 Geo. Hess*

RECEIVED  
STATE REGISTRATION COMMISSION

SEP 19 1958

REGISTRATION DIVISION

PLUGGING
FILE SEC 31 T 15 R 1W
BOOK PAGE 127 LINE 10