

WELL PLUGGING RECORD

Give All Information Completely
Make Required Affidavit
Mail or Deliver Report to:
Conservation Division
State Corporation Commission
211 No. Broadway
Wichita, Kansas

Saline County, Sec. 33 Twp. 15 Rge. (E) 1 (W)

Location as "NE/CNW/SW" or footage from lines NW NW SW

Lease Owner Dale Reese

Lease Name Mason "B" Well No. 1

Office Address Salina, Kansas

Character of Well (completed as Oil, Gas or Dry Hole) Dry hole

Date well completed 12/21/65 19 65

Application for plugging filed 12/21 19 65

Application for plugging approved " 19 65


Plugging commenced " 19 65

Plugging completed " 19 65

Reason for abandonment of well or producing formation dry hole

If a producing well is abandoned, date of last production 19

Was permission obtained from the Conservation Division or its agents before plugging was commenced? yes

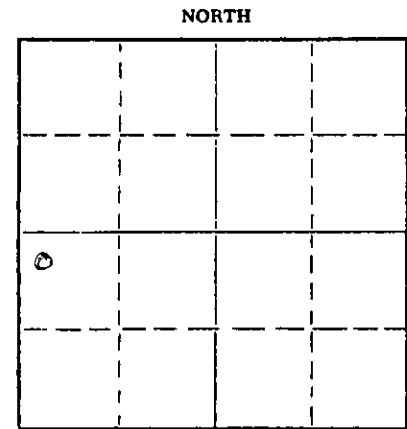

Locate well correctly on above Section Plat

Name of Conservation Agent who supervised plugging of this well Gilbert Toman

Producing formation Depth to top Bottom Total Depth of Well 2624 Feet

Show depth and thickness of all water, oil and gas formations.

OIL, GAS OR WATER RECORDS

CASING RECORD

FORMATION	CONTENT	FROM	TO	SIZE	PUT IN	PULLED OUT
				8 5/8"	133'	none

Describe in detail the manner in which the well was plugged, indicating where the mud fluid was placed and the method or methods used in introducing it into the hole. If cement or other plugs were used, state the character of same and depth placed, from feet to feet for each plug set.

heavy mud 2624 to 125
 wooden plug @ 125
 20sx cement on plug
 heavy mud to 40'
 wooden plug @ 40'
 10sx cement on plug
 surface soil 5' to 0'

STATE CORPORATION COMMISSION

JAN 10 1966
1-10-66

CONSERVATION DIVISION

(If additional description is necessary, use BACK of this sheet)
Name of Plugging Contractor Melland Drilling Co., Inc.
Address Box 783, McPherson, Kansas

STATE OF Kansas, COUNTY OF McPherson, ss.
Donald J. Melland (employee of owner) or (owner) of the above-described

well, being first duly sworn on oath, says: That I have knowledge of the facts, statements, and matters herein contained and the log of the above-described well as filed and that the same are true and correct. So help me God.

(Signature) Donald J. Melland

Box 783, McPherson, Kansas (Address)

SUBSCRIBED AND SWORN TO before me this 27th day of December, 19 65

My commission expires December 23, 1967

Notary Public

WELL RECORD

LEASE: Masor "B"

WELL NO. 1

ELEVATION: 1243 RB

LOCATION: NW NW SW
Sec. 33-15-1W

COMMENCED: 12/16/65

COMPLETED: 12/21/65

OPERATOR: Dale Reese

CONTRACTOR: Melland Drilling Company, Inc.
Post Office Box 783
McPherson, Kansas

CASING RECORD: 8 5/8" @ 133' / 90ex

FORMATION	LOG
surface clay & sand	55
anhydrite	160
lime	750
shale 1976	1976
lime	2005
lime & shale	2355
shale & shells	2624
RTD	2624
Sample Tops	
Lansing	1975
Mississippian	2616

DST #1 2617-2624, open 1 hr. weak blow for 9 min., rec. 1 ft. of oil and 16' of very slightly oil cut mud., BHP 650 & 492 / 20 min., PP 9 & 9

RECEIVED
STATE CORPORATION COMMISSION
JAN. 10 1966
CONSERVATION DIVISION
Wichita, Kansas

CERTIFICATE

State of Kansas, County of McPherson, ss.

I, Donald J. Melland, do hereby certify that the above is a true and correct copy of the log of the above named and described well, as reflected by the records of the Melland Drilling Company, Inc.

Donald J. Melland

Subscribed and sworn to before me, a Notary Public, in and for the County of McPherson, State of Kansas.

this 27th day of December, 1965.

Jim B. [Signature]
_____ Notary Public

My Commission expires: December 23, 1967