


WELL PLUGGING RECORD

Give All Information Completely  
Make Required Affidavit  
Mail or Deliver Report to:  
Conservation Division  
State Corporation Commission  
800 Bittling Building  
Wichita, Kansas

Saline County, Sec. 33 Twp. 15 Rge. 1 (E) (W)  
Location as "NE/CNW&SWK" or footage from lines C NE SE SW  
Lease Owner Donald T. Ingling, et al  
Lease Name Mortimer Well No. 1  
Office Address 611 Orpheum Bldg., Wichita 2, Kansas  
Character of Well (completed as Oil, Gas or Dry Hole) Dry Hole  
Date well completed September 13, 19 53  
Application for plugging filed September 13, 19 53  
Application for plugging approved September 13, 19 53  
Plugging commenced September 13, 19 53  
Plugging completed September 13, 19 53  
Reason for abandonment of well or producing formation Dry

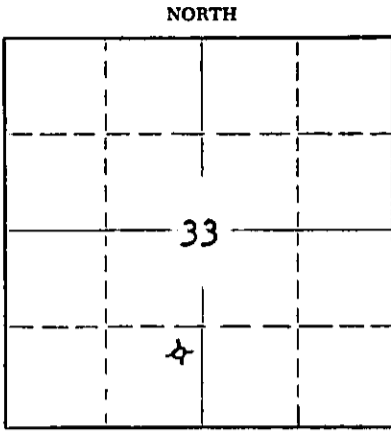

Locate well correctly on above Section Plat

If a producing well is abandoned, date of last production 19  
Was permission obtained from the Conservation Division or its agents before plugging was commenced? Yes

Name of Conservation Agent who supervised plugging of this well Ruel Durkee, McPherson, Kansas  
Producing formation Depth to top Bottom Total Depth of Well 2648 Feet  
Show depth and thickness of all water, oil and gas formations.

OIL, GAS OR WATER RECORDS

CASING RECORD

FORMATION	CONTENT	FROM	TO	SIZE	PUT IN	PULLED OUT
				8 5/8"	105'	None

Describe in detail the manner in which the well was plugged, indicating where the mud fluid was placed and the method or methods used in introducing it into the hole. If cement or other plugs were used, state the character of same and depth placed, from feet to feet for each plug set.

Gunned pits with pipe on bottom - circulated one hour and laid down one-half drill pipe - circulated one-half hour and laid down balance of drill pipe. Put solid bridge at 105 feet then 15 sacks cement - filled hole to within 20 feet of top and capped with 5 sacks cement.

9-15-53

(If additional description is necessary, use BACK of this sheet)

Name of Plugging Contractor Donald T. Ingling  
Address Wichita, Kansas

STATE OF Kansas, COUNTY OF Sedgwick, ss.  
D. T. Ingling (employee of owner) or (owner or operator) of the above-described well, being first duly sworn on oath, says: That I have knowledge of the facts, statements, and matters herein contained and the log of the above-described well as filed and that the same are true and correct. So help me God.


(Signature) *D. T. Ingling*  
611 Orpheum Bldg., Wichita 2, Kansas  
(Address)

SUBSCRIBED AND SWORN TO before me this 14th day of September, 19 53

*M E Black*

Notary Public.

My commission expires February 27, 1956

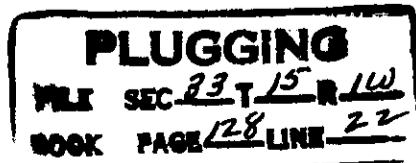

WELL LOG - MORTIMER NO. 1

Donald T. Ingling, et al, Lease Owner

Section 33-15-1W

Donald T. Ingling, Operator

Location: C NE SE SW

Commenced: 8-25-53

County: Saline, Kansas

Completed: 9-13-53

Production: dry

Total Depth: 2648'

Elevation: 1244' DF

Casing: 8 5/8" x 105' (70 sacks cement)

Figures below indicate bottom formation

35	Surface clay	1670	Lime and shale streaks
45	Sand	1725	Lime and shale streaks
105	Shale and shells	1790	Lime and shale
215	Lime	1875	Lime and shale
280	Lime and shale	1925	Shale
305	Lime	1980	Shale
440	Lime	1990	Lime
545	Lime	2030	Lime
645	Lime and shale	2085	Lime
725	Lime	2130	Lime
745	Shale and red rock	2175	Lime
890	Shale and lime	2230	Lime
1110	Shale and shells	2280	Lime
1140	Shale and lime	2317	Lime
1265	Lime (broken)	2395	Shale and shells
1390	Shale	2455	Shale
1490	Shale and lime	2480	Lime
1555	Lime (cherty)	2510	Lime and shale
1585	Lime and shale	2570	Shale
		2610	Shale
		2613	Top Mississippi
		2634	Lime and shale
		2648	Lime - Mississippi
		2648	Total Depth

I certify this is a true and correct log of the above mentioned well.

*D. T. Ingling*  
 \_\_\_\_\_  
 D. T. Ingling

State of Kansas )

ss

Sedgwick County )

**PLUGGING**

FILE SEC 33 T 15 R 14W

BOOK PAGE 128 LINE 22

Subscribed and sworn to before me, Notary Public in said County and State.

*W. E. Beach*  
 \_\_\_\_\_  
 Notary Public

My commission expires February 27, 1956