


STATE OF KANSAS
 STATE CORPORATION COMMISSION
 Give All Information Completely
 Make Required Affidavit
 Mail or Deliver Report to:
 Conservation Division
 State Corporation Commission
 212 North Market, Insurance Bldg.
 Wichita, Kansas

15-169-00691-0000
WELL PLUGGING RECORD

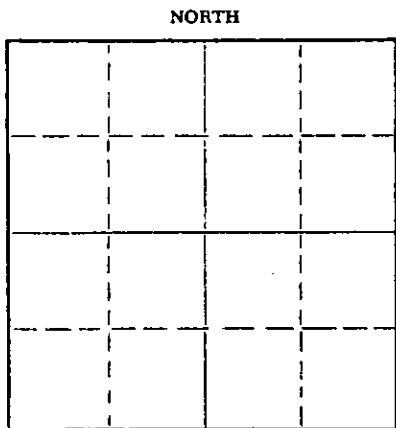

Locate well correctly on above Section Plat

Saline County. Sec. 33 Twp. 15 Rge. 1W (E) (W)
 Location as "NE/CNW%SW%" or footage from lines 3L SW SW
 Lease Owner I. O. Miller
 Lease Name Mortimer Well No. 2
 Office Address 619 Brown Building, Wichita
 Character of Well (completed as Oil, Gas or Dry Hole) Dry hole
 Date well completed 1-2-61 19__
 Application for plugging filed " " " 19__
 Application for plugging approved " " " 19__
 Plugging commenced " " " 19__
 Plugging completed " " " 19__
 Reason for abandonment of well or producing formation DRY

If a producing well is abandoned, date of last production _____ 19__
 Was permission obtained from the Conservation Division or its agents before plugging was commenced? YES

Name of Conservation Agent who supervised plugging of this well Gilbert Toman
 Producing formation _____ Depth to top _____ Bottom _____ Total Depth of Well _____ Feet
 Show depth and thickness of all water, oil and gas formations.

OIL, GAS OR WATER RECORDS				CASING RECORD		
FORMATION	CONTENT	FROM	TO	SIZE	PUT IN	PULLED OUT

Describe in detail the manner in which the well was plugged, indicating where the mud fluid was placed and the method or methods used in introducing it into the hole. If cement or other plugs were used, state the character of same and depth placed, from _____ feet to _____ feet for each plug set.

Filled hole with mud to 200 feet and then set plug and hulls in a sack; poured 10 sacks of cement down drill pipe and then filled to 30 feet with mud; set a plug, hulls in a sack and filled to surface with 5 sacks cement; plugged rat hole with 2 sacks cement.

(If additional description is necessary, use BACK of this sheet)
 Name of Plugging Contractor Eureka Drilling Company
 Address Hamilton, Kansas

STATE OF Kansas, COUNTY OF Hammond, ss.
 _____ (employee of owner) or (owner or operator) of the above-described well, being first duly sworn on oath, says: That I have knowledge of the facts, statements, and matters herein contained and the log of the above-described well as filed and that the same are true and correct. So help me God.

(Signature) Henry Martell
Hamilton, Kansas (Address)

SUBSCRIBED AND SWORN TO before me this 3 day of Jan, 1961
Wacker Lewis

WALKER ELLIS NOTARY PUBLIC
 My commission expires Greenwood County, Kansas
 My Commission Expires Aug. 9, 1962
 Notary Public.

15-169-00691-0000

R

Company: I. O. Miller
Farm: Mortimer
Well: #2
Location: SL SW SW 33-15-1w-Saline County, Kansas
Date: Commenced 12-23-60
Completed 12-30-60
Casing Record: 212 feet of 7" surface casing
Contractor: Eureka Drilling Company
Well: #2

Figures indicate bottoms of formations from the rotary table bushings which are 5½ feet above ground level;-

12	soil
24	lime
31	gravel
56	lime
196	lime and shale
220	lime
370	lime and shale strks
565	shale and lime
730	lime w/shale strks
910	lime and shale
1205	shale
1500	shale and shells
1695	shale and lime
1820	lime
1900	shale
1930	lime and sandy lime
1945	red rock
1990	shale
2305	lime
2365	shale
2465	lime and sandy lime
2505	lime
2560	lime and shale
2637	lime
2637	RTD