

STATE OF KANSAS
STATE CORPORATION COMMISSION

WELL PLUGGING RECORD


OR

FORMATION PLUGGING RECORD

Strike out upper line
when reporting plug-
ging of formations.

Give All Information Completely
Make Required Affidavit
Mail or Deliver Report to:
Conservation Division
State Corporation Commission
800 Bitting Building
Wichita, Kansas

NORTH

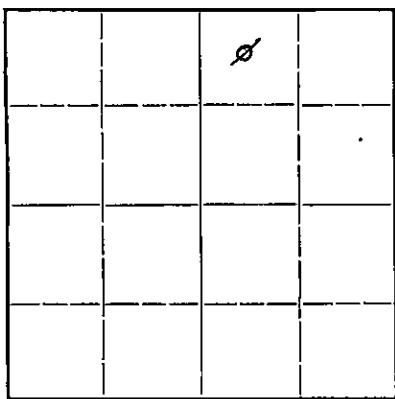

Locate well correctly on above
Section Plat

Saline County, Sec. 33 Twp. 15 Rge. (E) 1 (W) 1
Location as "NE 1/4 NW 1/4 SW 1/4" or footage from lines approx. C NW 1/4 NE 1/4
Lease Owner The Stelbar Oil Corp. et al
Lease Name Agin Well No. 1
Office Address 310 Petroleum Bldg., Wichita, Kansas
Character of Well (completed as Oil, Gas or Dry Hole) dry hole
Date well completed May 15, 1942
Application for plugging filed May 15, 1942
Application for plugging approved May 15, 1942
Plugging commenced May 15, 1942
Plugging completed May 16, 1942
Reason for abandonment of well or producing formation

If a producing well is abandoned, date of last production 19...
Was permission obtained from the Conservation Division or its agents before plugging was com-
menced? yes

Name of Conservation Agent who supervised plugging of this well Ruel Durkee
Producing formation Depth to top Bottom Total Depth of Well Feet

Show depth and thickness of all water, oil and gas formations.

OIL, GAS OR WATER RECORDS


CASING RECORD

Formation	Content	From	To	Size	Put In	Pulled Out
chat	dry	2608	2656	10 1/2"	147'	none

Describe in detail the manner in which the well was plugged, indicating where the mud fluid was placed and the method or methods used in introducing it into the hole. If cement or other plugs were used, state the character of same and depth placed, from feet to feet for each plug set.

Filled hole with mud to 160'.
Set plug at 160' and put in 15 sax of cement.
Filled with mud to 20', set plug and cemented with 6 sax.
Welded cap on top of surface casing.
Filled cellar.

PLUGGING
FILE # 33-15-71W
BOOK PAGE 33 LINE 39

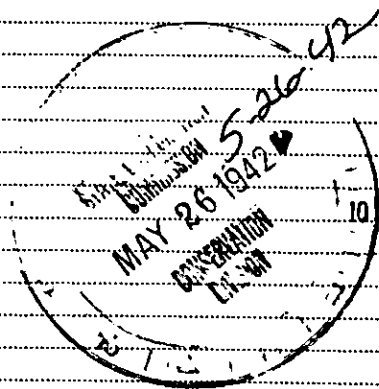

(If additional description is necessary, use BACK of this sheet)

Correspondence regarding this well should be addressed to The Stelbar Oil Corp.
Address 310 Petroleum Bldg., Wichita, Kansas

STATE OF Kansas, COUNTY OF Sedgwick, ss.
D. M. Shawver (employee of owner) or owner or operator of the above-described well,

being first duly sworn on oath, says: That I have knowledge of the facts, statements, and matters herein contained and the log of the above-described well as filed and that the same are true and correct. So help me God.

(Signature) D M Shawver
310 Petroleum Bldg., Wichita, Kansas
(Address)

SUBSCRIBED AND SWORN to before me this 23rd day of May, 1942

Notary Public. (Signature)

My commission expires Dec. 16, 1945.

L O G

The Stelbar Oil Corp., et al
 Farm: J. F. Agin well #1
 Location: approx. C NW/4 NE/4 Sec. 33-15S-1W, Saline Co., Kansas
 Drilling commenced: May 4, 1942
 Drilling completed: May 15, 1942
 Contractor: E. B. Shawver Elevation: 1229

surface	23
sand	30
sand & shale	65
lime	310
red rock	320
lime	390
shale	420
lime	485
shale & shells	522
lime	587
shale	1425
sand	1435
shale	1525
lime	1775
shale	1901
lime	1908
lime sandy	1918
shale	1963
K.C. lime	2217
shale	2225
lime	2300
shale	2608
chat	2642
lime	2656
Total Depth	2656 D & A

Casing Record:

10" 147' cemented w/75 sax

