

STATE OF KANSAS
STATE CORPORATION COMMISSION

WELL PLUGGING RECORD

A 4x4 grid with dashed lines for drawing.

Locate well correctly on above
Section Plat

Name of Conservation Agent who supervised plugging of this well Gilbert Toman
Producing formation _____ Depth to top _____ Bottom _____ Total Depth of Well _____ Feet
Show depth and thickness of all water, oil and gas formations.

Name of Conservation Agent who supervised plugging of this well Gilbert Toman

If a producing well is abandoned, date of last production _____ 19____

Was permission obtained from the Conservation Division or its agents before plugging was commenced? Yes




CASING RECORD

CASING RECORD

OIL, GAS OR WATER RECORDS

CASING RECORD

Describe in detail the manner in which the well was plugged, indicating where the mud fluid was placed and the method or methods used in introducing it into the hole. If cement or other plugs were used, state the character of same and depth placed, from _____ feet to _____ feet for each plug set.

Filled with mud to 130 ft. Set plug and put in 20 sacks of cement. Filled hole to 40 ft., set plug and put in 10 sacks of cement. 2 sacks in rathole. Plug down at 7:30 A. M., April 23, 1971. Plugging completed by State Plugger, Gilbert Toman, Holyrood, Kansas.

This hole is clean no slugs left in hole.
STATE REC'D. DRH.

RECEIVED
STATE CORPORATION COMMISSION
APR 28 1971
CONSERVATION DIVISION
WICHITA, KANSAS


(If additional description is necessary, use BACK of this sheet)

Name of Plugging Contractor Blackstone Drilling, Inc.
Address Box 455, McPherson, Kansas 67460

STATE OF Kansas, COUNTY OF McPherson, ss.
George R. Hess (employee of owner) or (owner or operator) of the above-described well, being first duly sworn on oath, says: That I have knowledge of the facts, statements, and matters herein contained and the log of the above-described well as filed and that the same are true and correct. So help me God.

(Signature) George R. Hess
505 N. Charles, McPherson, Kansas 67460
(Address)

NO. 126 SUBSCRIBED AND SWORN to before me this 16 day of April, 1977
PUBLISHED Carroll D. Winslow
My commission expires January 17, 1973 Notary Public.
WEDSON CO.

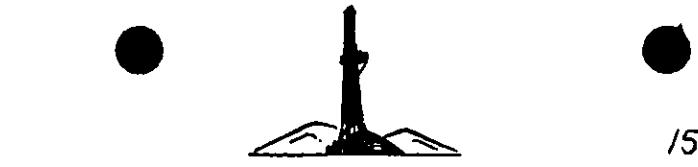

15-169-20047-0000

Blackstone Drilling, Inc.

Box 455 • 523 West Kansas • Phone CH 1-1250

McPHERSON, KANSAS 67460
April 26, 1971

COMPANY:

GEORGE R. NESS

CONTRACTOR:

BLACKSTONE DRILLING, INC.

FARM:

MC CLOSKEY #1

LOCATION:

SE SW NW, Sec. 32-15-1W,
Saline County, Kansas

COMMENCED:

April 18, 1971

COMPLETED:

April 23, 1971

ELEVATION:

1302 K. B.

0	to	135	
135	to	910	Shale & Shells
910	to	1560	Lime
1560	to	2600	Shale & Lime
2600	to	2700	Lime
2700	to	2706	Lime & Shale
2706	to	2730	Burgess Sand
		2730	Mississippi
			T. D.


Cut 12 1/4 in. hole to 135 ft. and run 138 ft. of 8 5/8 in. surface pipe, cemented with 100 sacks of cement at 135 ft. Plug down at 11:30 A. M., April 18, 1971. Cut 7 7/8 in. hole to 2730 ft. Hole dry and abandoned. Filled with mud to 130 ft. Set plug and put in 20 sacks of cement. Filled hole to 40 ft., set plug and put in 10 sacks of cement. Put 2 sacks in rat hole. Plugging completed at 7:30 A. M., April 23, 1971. Plugging completed by State Plumber, Gilbert Toman, Holbrood, Kansas.

TOPS: BURGESS SAND - 2700' MISSISSIPPI - 2706'

Measurements taken from K. B.

CERTIFICATE

I, H. J. Plouffe, President of Blackstone Drilling, Inc. do hereby certify that the above and foregoing is a true and correct copy of log on your Mc Closkey #1, located on the SE SW NW, Sec. 32-15-1W, Saline County, Kansas as reflected by the files of Blackstone Drilling, Inc.

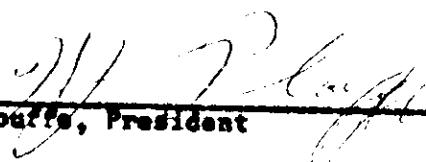
H. J. Plouffe, President

Subscribed and sworn to before me a Notary Public in and for McPherson County, Kansas this 26th day of April, 1971.


Johnnie L. Schmidt - Notary Public

