

15.169.000 27.0000

STATE OF KANSAS
STATE CORPORATION COMMISSION

WELL PLUGGING RECORD


Give All Information Completely
Make Required Affidavit
Mail or Deliver Report to:
Conservation Division
State Corporation Commission
800 Bitting Building
Wichita, Kansas

OR

FORMATION PLUGGING RECORD

Strike out upper line
when reporting plug-
ging off formations.

NORTH

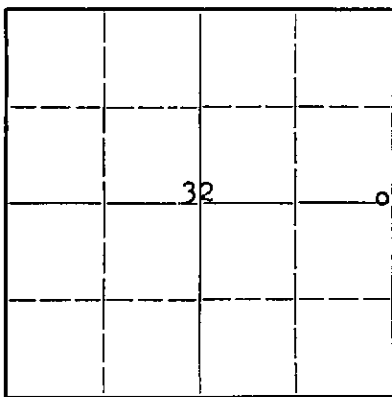

Locate well correctly on above
Section Plat

Saline County. Sec. 32 Twp. 15 Rge. 1 (W)
Location as "NE $\frac{1}{4}$ NW $\frac{1}{4}$ SW $\frac{1}{4}$ " or footage from lines. NE - SE
Lease Owner F. S. Williams
Lease Name Lucy Mortimer Well No. 1
Office Address Box 746 McPherson, Kansas
Character of Well (completed as Oil, Gas or Dry Hole) Dry Hole
Date well completed 7/13/52
Application for plugging filed 9/17/52
Application for plugging approved 7/13/52
Plugging commenced 8/2/52
Plugging completed 8/5/52
Reason for abandonment of well or producing formation Dry

If a producing well is abandoned, date of last production 19
Was permission obtained from the Conservation Division or its agents before plugging was com-
menced? Yes

Name of Conservation Agent who supervised plugging of this well Ruel Durkee
Producing formation Chat Depth to top 2616 Bottom 2648 Total Depth of Well 2648 Feet
Show depth and thickness of all water, oil and gas formations.

OIL, GAS OR WATER RECORDS

CASING RECORD

Formation	Content	From	To	Size	Put In	Pulled Out
Chat	Sho Oil	2614	25	8"	130'	None
	H. F. W.	2625	48	5"	2628	2410

Describe in detail the manner in which the well was plugged, indicating where the mud fluid was placed and the method or methods used in introducing it into the hole. If cement or other plugs were used, state the character of same and depth placed, from.....feet to.....feet for each plug set.

Dumped 5 sacks of cement at 2648. Sand to 2616. Dumped 10 sacks of cement at 2616.
Shot pipe off at 2410. Pulled pipe and mudded hole to 135'. Set rock bridge at 135'.
Put 15 sacks cement at 125' finished mudding hole and put 5 sacks cement at top of surface.

RECEIVED
STATE CORPORATION COMMISSION
SEP 18 1952
9-18-52
CONSERVATION DIVISION
Wichita, Kansas

(If additional description is necessary, use BACK of this sheet)


Correspondence regarding this well should be addressed to F. S. Williams
Address Box 746 McPherson, Kansas

STATE OF Kansas, COUNTY OF McPherson, ss.
F. S. Williams (employee of owner) or (owner or operator) of the above-described well,
being first duly sworn on oath, says: That I have knowledge of the facts, statements, and matters herein contained and the log of the above-
described well as filed and that the same are true and correct. So help me God.

(Signature) F. S. Williams
748 E. Marlin (Address)

SUBSCRIBED AND SWORN to before me this 17 th day of September 19 52
Notary Public.

My commission expires 9-14-1954

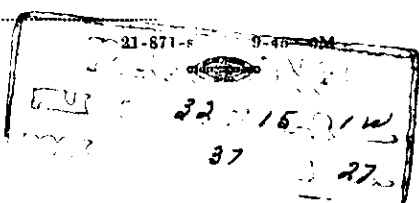

COMPANY: F. S. Williams
 CONTRACTOR: Mallard Drilling Company
 FARM: Lucy Mortimer #1
 LOCATION: NE NE SE Sec. 32-15-1W
 Saline County, Kansas
 COMMENCED: June 27, 1952 --rotary
 COMPLETED: July 3, 1952--rotary

0	to	60	Sand
60	to	132	Shale and lime
132	to	200	Lime and shale
200	to	365	Lime
365	to	570	Sandy lime
570	to	740	Lime and sand
740	to	1000	Lime, sand and shale
1000	to	1495	Lime and shale
1495	to	1710	Lime and shale
1710	to	1850	Lime and sand
1850	to	2000	Lime and shale
2000	to	2115	Lime and shale
2115	to	2215	Lime
2215	to	2335	Lime and shale
2335	to	2555	Lime and shale
2555	to	2610	Shale
2610	to	2616	Chat
		2616	T.D. Rotary

Cable Tools

26 16 - 25' Chat 500 Oil
 26 25 - 48' LM & Chat HFU 2648 DYA.

Set 132' of 8 5/8" surface pipe. Cemented with 90 sacks cement.

5 1/2" cemented at 2616. Cemented with 25 sacks.

TOPS: Chat 2608

Measurements taken from derrick floor

RECEIVED
 STATE CONSERVATION COMMISSION
 SEP 1 1952
 CONSERVATION DIVISION
 Wichita, Kansas

C E R T I F I C A T E

I, Max Wright, do hereby certify that the above and foregoing is a true and correct copy of log of the Lucy Mortimer #1, Sec. 32-15-1W, Saline County, Kansas, as reflected by files of the Mallard Drilling Company.

Subscribed and sworn to before me a Notary Public, within and for Sedgewick County, Kansas, this 10th day of July 1952.

[Signature]
 Marcella A. Davis

My commission expires Feb 27-1956.

PLUGGING
 FILE 200-227-15-11W
 BOOK 100-22-317-21