


Give All Information Completely
Make Required Affidavit
Mail or Deliver Report to:
Conservation Division
State Corporation Commission
211 No. Broadway
Wichita, Kansas

WELL PLUGGING RECORD

NORTH

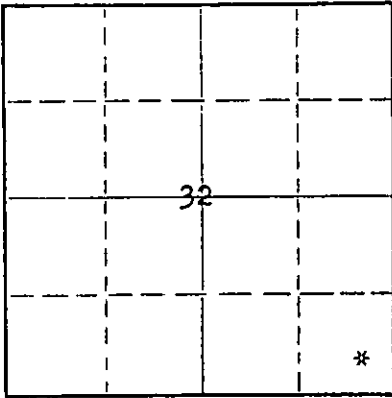

Locate well correctly on above
Section Plat

Saline County, Sec. 32 Twp. 15S Rge. (E) 1 (W)
Location as "NE/CNWxSWx" or footage from lines SE/4 SE/4 SE/4
Lease Owner Dale Reese
Lease Name Lucy Mortimer Well No. 1
Office Address 139 No. Santa Fe, Salina, Kansas
Character of Well (completed as Oil, Gas or Dry Hole) Dry Hole
Date well completed December 21, 1962
Application for plugging filed December 21, 1962
Application for plugging approved 19
Plugging commenced December 21, 1962
Plugging completed December 21, 1962
Reason for abandonment of well or producing formation Dry Hole

If a producing well is abandoned, date of last production 19
Was permission obtained from the Conservation Division or its agents before plugging was commenced? Yes

Name of Conservation Agent who supervised plugging of this well Cecil Jones
Producing formation _____ Depth to top _____ Bottom _____ Total Depth of Well 2655 Feet
Show depth and thickness of all water, oil and gas formations.

OIL, GAS OR WATER RECORDS

CASING RECORD

FORMATION	CONTENT	FROM	TO	SIZE	PUT IN	PULLED OUT
				8-5/8"	148'	None

Describe in detail the manner in which the well was plugged, indicating where the mud fluid was placed and the method or methods used in introducing it into the hole. If cement or other plugs were used, state the character of same and depth placed, from _____ feet to _____ feet for each plug set.

2655' to 145' - Heavy Mud
145' - Wood Plug
145' to 85' - 20 Sacks of Cement
85' to 30' - Heavy Mud
30' - Wood Plug
30' to 6' @ 8 Sacks of Cement
6' to 0' - Surface Soil

1-14-63

(If additional description is necessary, use BACK of this sheet)

Name of Plugging Contractor Melland Drilling Company, Inc.
Address 1111 North Main Street, Hutchinson, Kansas

STATE OF Kansas COUNTY OF Saline ss.
Dale Reese (employee of owner) or (owner or operator) of the above-described well, being first duly sworn on oath, says: That I have knowledge of the facts, statements, and matters herein contained and the log of the above-described well as filed and that the same are true and correct. So help me God.

(Signature) Dale Reese
139 N Santa Fe, Salina, Kansas
(Address)

SUBSCRIBED AND SWORN to before me this 11 day of January, 1963

My commission expires 2-8-65
Oleta L. Young Notary Public.



15-169-00745-0000

W E L L R E C O R D

LEASE: Lucy Mortimer

WELL NO. 1

LOCATION: SE/4 SE/4 SE/4
Sec. 32-15S-1W
Saline County, Kansas

COMMENCED: 12/16/62

COMPLETED: 12/21/62
(rotary)

OPERATOR: Dale Reese
139 No. Santa Fe
Salina, Kansas

CONTRACTOR: Melland Drilling Company, Inc.
1111 North Main Street
Hutchinson, Kansas

CASING RECORD: 8-5/8" OD set at 148' with 110 sacks of cement.

FORMATION

LOG

Surface soil, shale & clay	65
Anhydrite	148
Lime & shale	715
Shale & shells	1450
Lime & shale	1800
Shale & shells	1987
Lime & shale	2288
Shale & shells	2600
Shale	2625
Mississippi Lime	2655

ROTARY TOTAL DEPTH

PB from 2655' to 145' w/ heavy mud,
set wood plug at 145', 145' to 85'
w/ 20 sacks of cement, 85' to 30' w/
heavy mud, set wood plug at 30', 30'
to 6' w/ 8 sacks of cement, 6' to
surface w/ soil. Flugged and
abandoned 12/21/62.