


15169-190540000

WELL PLUGGING RECORD

Give All Information Completely  
Make Required Affidavit  
Mail or Deliver Report to:  
Conservation Division  
State Corporation Commission  
211 No. Broadway  
Wichita, Kansas

Saline County. Sec. 32 Twp. 15S Rge. 1 (E) 1 (W)  
Location as "NE/CNW&SW&" or footage from lines C S/2 S/2 SE/4  
Lease Owner General American Oil Co. of Texas  
Lease Name Lucy Mortimer Well No. 1  
Office Address Box 352, Hutchinson, Kansas  
Character of Well (completed as Oil, Gas or Dry Hole) Dry Hole  
Date well completed 6/28 1958  
Application for plugging filed 6/28 1958  
Application for plugging approved 6/28 1958  
Plugging commenced 6/28 1958  
Plugging completed 6/28 1958  
Reason for abandonment of well or producing formation Dry hole

NORTH

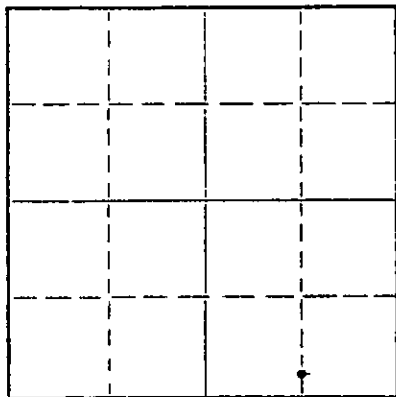

Locate well correctly on above Section Plat

If a producing well is abandoned, date of last production 19  
Was permission obtained from the Conservation Division or its agents before plugging was commenced? Yes

Name of Conservation Agent who supervised plugging of this well Delbert Harolder  
Producing formation \_\_\_\_\_ Depth to top \_\_\_\_\_ Bottom \_\_\_\_\_ Total Depth of Well 2649 Feet  
Show depth and thickness of all water, oil and gas formations.

OIL, GAS OR WATER RECORDS

CASING RECORD

FORMATION	CONTENT	FROM	TO	SIZE	PUT IN	PULLED OUT
				8-5/8"	181'	None

Describe in detail the manner in which the well was plugged, indicating where the mud fluid was placed and the method or methods used in introducing it into the hole. If cement or other plugs were used, state the character of same and depth placed, from \_\_\_\_\_ feet to \_\_\_\_\_ feet for each plug set.

Good plug with 1/2 sack hulls and 20 sacks cement at 170'  
Another plug and 1/2 sack hulls with 10 sacks cement at 40'

7-3-58  
101-3-15

(If additional description is necessary, use BACK of this sheet)  
Name of Plugging Contractor Greenland Drilling Company  
Address 4722 Broadway, Kansas City 12, Mo.

STATE OF Kansas, COUNTY OF Sedgwick, ss.  
Oscar Bridge, V. Pres. Greenland Drlg. Co. (employee of owner) or (owner or operator) of the above-described well, being first duly sworn on oath, says: That I have knowledge of the facts, statements, and matters herein contained and the log of the above-described well as filed and that the same are true and correct. So help me God.

(Signature) Oscar Bridge  
Oscar Bridge, Vice-President  
Greenland Drilling Company, K. C., Mo.  
(Address)

SUBSCRIBED AND SWORN TO before me this 30th day of June, 1958

Verdina B. Rutledge  
Notary Public.

My commission expires March 15, 1960

PLUGGING  
FILE SEC 32 T. 15 R. 1W  
BOOK PAGE 112 LINE 27

WELL LOG

Company: GENERAL AMERICAN OIL CO. OF TEXAS

32  
Sec. ~~32~~ Twp. 15 S Rge. 1W

Farm: LUCY MORTIMER

No. 1

Location: C S/2 S/2 SE/4

Saline County, Kansas

Commenced: 6/21/58

Completed: 6/28/58

Total Depth: 2649

Contractor: GREENLAND DRILLING COMPANY

Casing: 8-5/8" 181'

Elevation: 1253 RB

5-1/2" ---

Production: D &amp; A

## Figures Indicate Bottom of Formations

75	Soil and shale	TOPS:	
181	Lime & shale	Lansing	1990
685	Lime & shale	Mississippi	2626
1620	Shale & lime	RTD	2649
1921	Lime & shale		
1985	Shale & lime		
2065	Lansing		
2190	Lime & shale streaks		
2295	Lansing lime & shale		
2315	Lime		
2600	Shale & lime		
2627	Lime & shale		
2649	Miss.		
2649	RTD		

STATE OF KANSAS, COUNTY OF SEDGWICK, ss:

I, Oscar Bridge, of the Greenland Drilling Company, upon oath state that the above and foregoing is a true and correct copy of the log of the #1 Lucy Mortimer well.

*Oscar Bridge*  
Oscar Bridge, Vice-President

Subscribed and sworn to before me this 30th day of June, 1958.

*Verdina B. Rutledge*  
Verdina B. Rutledge, Notary Public

My commission expires March 15, 1960.

