

STATE OF KANSAS
STATE CORPORATION COMMISSION

Form CP-4

WELL PLUGGING RECORD

Give All Information Completely
Make Required Affidavit
Mail or Deliver Report to:
Conservation Division
State Corporation Commission

P. O. BOX 17027
Wichita, Kansas 67217
NORTH

Pratt County, Sec. 11 Twp. 27 Rge. 13 (E) W (W)

Location as "NE/CNW/SE/SW" or footage from lines NW NW NE

Lease Owner Bowers Drilling Co., Inc.

Lease Name Thomas Well No. # 1

Office Address 1434 Wichita Plaza ; Wichita, Ks. 67202

Character of Well (completed as Oil, Gas or Dry Hole)

Date well completed 19

Application for plugging filed January 19 72

Application for plugging approved January 19 72


Plugging commenced February 5 19 72

Plugging completed February 9 19 72

Reason for abandonment of well or producing formation

If a producing well is abandoned, date of last production 19

Was permission obtained from the Conservation Division or its agents before plugging was commenced? Yes

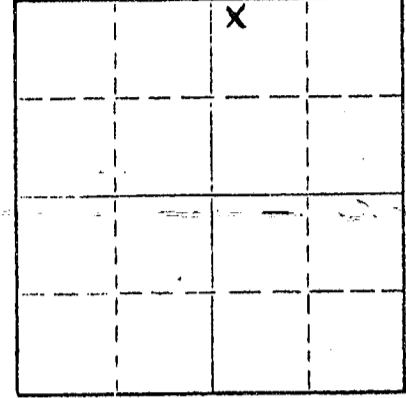

Locate well correctly on above Section Plat

Name of Conservation Agent who supervised plugging of this well Russell Biberstein

Producing formation Depth to top Bottom Total Depth of Well Feet

Show depth and thickness of all water, oil and gas formations.

OIL, GAS OR WATER RECORDS


CASING RECORD

FORMATION	CONTENT	FROM	TO	SIZE	PUT IN	PULLED OUT
				8 5/8"	465	None
				4 1/2"	4368	2820

Describe in detail the manner in which the well was plugged, indicating where the mud fluid was placed and the method or methods used in introducing it into the hole. If cement or other plugs were used, state the character of same and depth placed, from feet to feet for each plug set.

February 5, 1972 Plugged off bottom. Dumped sand to 4000'. Mixed and dumped 4 sx of cement.

February 9, 1972 Plugged off top. Set 10' rock bridge at 270'. Filled 8 5/8" surface casing from 270' to base of cellar with 3000 lb. P.S.I. ready-mix concrete.

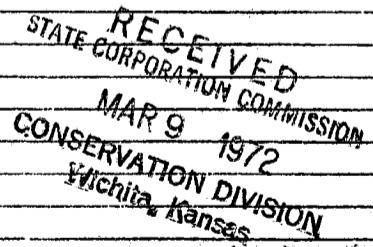

(If additional description is necessary, use BACK of this sheet)

Name of Plugging Contractor RUSS CASING PULLING, INC.


Address P. O. BOX 1082 ; GREAT BEND, KANSAS 67530

STATE OF KANSAS COUNTY OF SEDGWICK, ss.

Emil E. Bowers (employee of owner) or (owner or operator) of the above-described well, being first duly sworn on oath, says: That I have knowledge of the facts, statements, and matters herein contained and the log of the above-described well as filed and that the same are true and correct. So help me God.

(Signature) Emil E. Bowers Suite 1425, 125 North Market, Wichita, Kansas (Address)

Sworn to before me this 8th day of March, 19 72

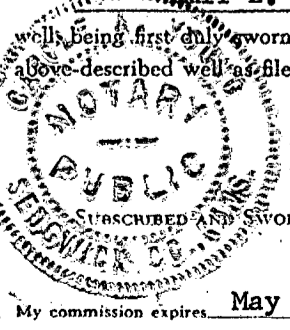

Carl R. Young Notary Public.

WELL LOG

COMPANY: Bowers Drilling Company, Inc.
 CONTRACTOR: Bowers Drilling Company
 FARM: Thomas #1
 LOCATION: N/2 NE/4 Section 11-27S-13W
 Pratt County, Kansas
 COMMENCED: 9-22-69
 COMPLETED: 10-3-69
 ELEVATION: 1926 Kelly Bushing
 1924 Derrick Floor
 1920 Ground Level

0 - 90	Sand	
90 - 1188	Red Bed	Set 8 5/8" casing at 465' W/375 saxs.
1188 - 1315	Shale and Lime	
1315 - 1970	Shale and shells	
1970 - 2150	Shale	
2150 - 3806	Shale and Lime	
3789 - 3821	Lime	(Board corrected uphole)
3821 - 3912	Lime and Shale	
3912 - 4128	Lime	
4128 - 4187	Lime and chert	
4187 - 4230	Lime	
4230 - 4275	Lime-Chert-Dolo. Shale	
4275 - 4276	Simpson Sand	
4276 - 4307	Lime	
4307 - 4310	Simpson Sand	
4310 - 4365	Lime and shale	
4365 - 4372	Arbuckle	
4372 - 4378	Lime	
4378	T. D.	Set 4 1/2" casing @ 4368 W/175 saxs.

LOG TOPS:

Heebner	3562(-1636)
Toronto	3577(-1651)
Douglas	3598(-1672)
Brown Lime	3725(-1799)
Lansing	3754(-1828)
Base/Kansas City	4075(-2149)
Mississippian	4181(-2255)
Viola	4221(-2295)
Simpson Shale	4263(-2337)
Simpson Dolomite	4270(-2344)
Simpson Sand	4287(-2361)
Arbuckle	4363(-2437)
Log T.D.	4376

RECEIVED
 STATE CORPORATION COMMISSION
 JAN 12 1972
 CONSERVATION DIVISION
 Wichita, Kansas

STATE OF KANSAS)
) SS
 COUNTY OF SEDGWICK)

I, Emil E. Bowers, do hereby certify that the above and foregoing is a true and correct copy of the log of the #1 Thomas located N/2 NE/4 Section 11-27S-13W, Pratt County, Kansas, as reflected by the files of Bowers Drilling Company, Inc..

Emil E. Bowers
 Emil E. Bowers

Subscribed and sworn to before me, a Notary Public, in and for the State of Kansas, this 24th day of October, 1969.

Carole A. Young
 Carole A. Young, Notary Public

My commission expires May 12, 1973

