


STATE OF KANSAS  
STATE CORPORATION COMMISSION

Give All Information Completely  
Make Required Affidavit  
Mail or Deliver Report to:  
Conservation Division  
State Corporation Commission  
212 North Market, Insurance Bldg.  
Wichita, Kansas

WELL PLUGGING RECORD

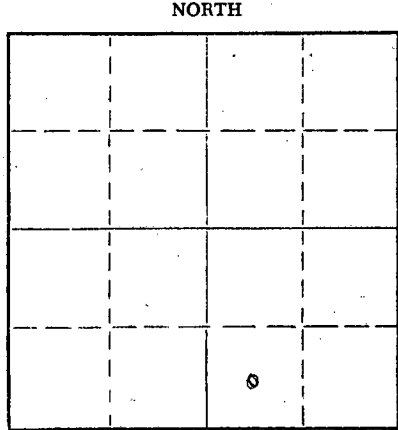

Locate well correctly on above  
Section Plat

Meade County, Sec. 29 Twp. 33S Rge. 29 (W)  
Location as "NE/CNWxSWx" or footage from lines 330' from south & 2310' from east  
Lease Owner Diamond Shamrock Corporation  
Lease Name Ida K. Heinson Well No. 6  
Office Address Box 631, Amarillo, Texas 79105  
Character of Well (completed as Oil, Gas or Dry Hole) Oil  
Date well completed 12-4-1957  
Application for plugging filed 4-20-1972  
Application for plugging approved 4-24-1972  
Plugging commenced 5-14-1972  
Plugging completed 5-17-1972  
Reason for abandonment of well or producing formation No longer capable of producing  
If a producing well is abandoned, date of last production April 1965  
Was permission obtained from the Conservation Division or its agents before plugging was commenced? Yes

Name of Conservation Agent who supervised plugging of this well E. Eves  
Producing formation Morrow Sand Depth to top 5806 Bottom 5821 Total Depth of Well 5983 Feet  
Show depth and thickness of all water, oil and gas formations.

OIL, GAS OR WATER RECORDS

CASING RECORD

FORMATION	CONTENT	FROM	TO	SIZE	PUT IN	PULLED OUT
Morrow Sand	Oil	5,806'	5,821'	13 3/8"	950'	
				7"	5,988.93'	2,720'


Describe in detail the manner in which the well was plugged, indicating where the mud fluid was placed and the method or methods used in introducing it into the hole. If cement or other plugs were used, state the character of same and depth placed, from \_\_\_\_\_ feet to \_\_\_\_\_ feet for each plug set.  
20 sacks cement from 4,125' to 4,000'  
60 sacks cement from 900' to 800'  
15 sacks cement from 40' to 3'.  
Welded plate on top of surface casing.

RECEIVED  
STATE CORPORATION COMMISSION  
MAY 25 1972  
05-25-72  
CONSERVATION DIVISION  
Wichita, Kansas

(If additional description is necessary, use BACK of this sheet)  
Name of Plugging Contractor Bob Sargent Casing Pulling  
Address Box 506, Liberal, Kansas 67901

STATE OF Texas, COUNTY OF Potter, ss.  
W. W. Killingsworth (employee of owner) or (owner or operator) of the above-described well, being first duly sworn on oath, says: That I have knowledge of the facts, statements, and matters herein contained and the log of the above-described well as filed and that the same are true and correct. So help me God.

(Signature) W. W. Killingsworth  
Box 631, Amarillo, Texas 79105 (Address)

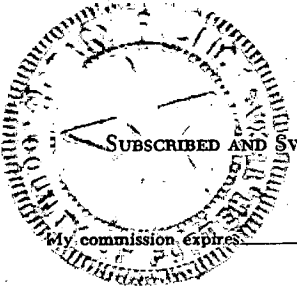

SUBSCRIBED AND SWORN TO before me this 23rd day of May, 1972  
Notary Public.

HEINSON #6

330' N of S Line & 2310' W of E Line of Section 29-33S-29W

Rigged up Rotary Tools 10/8/57 Ran 24 Jts. (960') 13 3/8" Casing set @ 950'. Cemented w/900 sacks cement.

Tore down Rotary Tools 11/13/57 Ran 188 Jts. (5988.93') 7" Casing set @ 5980.43'. Cemented w/150 sacks cement.

<u>FORMATION</u>	<u>FROM</u>	<u>TO</u>
Sand, clay & shale	0'	70'
Sand & Clay	70	420
Redbed & sand	420	705
Shells & shale	705	1005
Shale & shells w/sand streaks	1005	1250
Shale & shells	1250	1675
Anhydrite, shells & shale	1675	2142
Shale & lime	2142	2669
Lime	2669	2950
Lime & shale	2950	3010
Lime	3010	3064
Lime & shale	3064	3110
Lime	3110	3411
Lime & shale	3411	3726
Lime	3726	3787
Lime & shale	3787	4230
Shale	4230	4245
Lime	4245	4290
Heebner	4290	4357
Shale	4357	4369
Lime & shale	4369	4468
Lime	4468	5070
Lime & shale	5070	5202
Lime	5202	5314
Lime w/shale streaks	5314	5431
Lime	5431	5565
Lime & shale	5565	5615
Lime	5615	5649
Lime w/shale streaks	5649	5689
Lime & shale	5689	5736
Sand & shale	5736	5895
Lime & chert	5895	5953
Lime & shale	5953	5983

RECEIVED  
STATE CORPORATION COMMISSION  
APR 24 1972  
CONSERVATION DIVISION  
Wichita, Kansas

T. D.

I, W. M. Barnett, do hereby certify that the foregoing log is true and correct, to the best of my knowledge and belief.

W. M. Barnett  
W. M. Barnett

Subscribed and sworn to before me this 14th day of November, 1957.

June Swanson  
Notary Public

My Commission Expires: July 29, 1961