

Give All Information Completely  
Make Required Affidavit  
Mail or Deliver Report to:  
Conservation Division  
State Corporation Commission  
212 North Market, Insurance Bldg.  
Wichita, Kansas

WELL PLUGGING RECORD

Kingman County, Sec. 21 Twp. 29 Rge. 7 (E) W. (W)

Location as "NE/CNW/SW" or footage from lines 1650' S. & 990' W. of NE Cor.

Lease Owner Cities Service Oil Company

Lease Name Campbell "D" Well No. 1

Office Address Box 144, Great Bend, Kansas

Character of Well (completed as Oil, Gas or Dry Hole) Dry Hole

Date well completed December 29 19 59

Application for plugging filed December 30 19 59

Application for plugging approved December 30 19 59


Plugging commenced December 30 19 59

Plugging completed December 30 19 59

Reason for abandonment of well or producing formation Dry Hole

If a producing well is abandoned, date of last production - 19 -

Was permission obtained from the Conservation Division or its agents before plugging was commenced? Fred Hampel

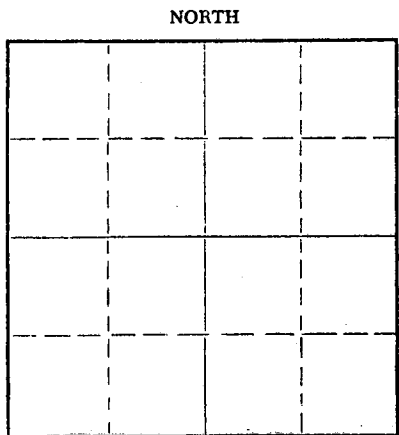

Name of Conservation Agent who supervised plugging of this well

Producing formation None Depth to top - Bottom - Total Depth of Well 4255 Feet

Show depth and thickness of all water, oil and gas formations.

OIL, GAS OR WATER RECORDS

CASING RECORD

FORMATION	CONTENT	FROM	TO	SIZE	PUT IN	PULLED OUT
				8-5/8"	397'	None

Describe in detail the manner in which the well was plugged, indicating where the mud fluid was placed and the method or methods used in introducing it into the hole. If cement or other plugs were used, state the character of same and depth placed, from \_\_\_\_\_ feet to \_\_\_\_\_ feet for each plug set.

- 4255-240', heavy mud.
- 240-186', wood plug, hulls and 18 sacks cement.
- 186- 35', heavy mud.
- 35' to base of cellar, wood plug, hulls and 10 sacks cement.

REC'D  
STATE CORPORAT  
MISSION  
JAN 15 1960  
CONSERVATION DIVISION  
Wichita, Kansas  
01-15-60

(If additional description is necessary, use BACK of this sheet)

Name of Plugging Contractor Barbour Drilling Company  
Address Tulsa, Oklahoma

STATE OF Kansas, COUNTY OF Barton, ss.  
John D. Forsyth (employee of owner) or (owner or operator) of the above-described

well, being first duly sworn on oath, says: That I have knowledge of the facts, statements, and matters herein contained and the log of the above-described well as filed and that the same are true and correct. So help me God.

(Signature) John Forsyth  
Box 144, Great Bend, Kansas  
(Address)

SUBSCRIBED AND SWORN TO before me this 4th day of January 19 60

W. D. Smith  
Notary Public.

My commission expires March 12, 1963.



WELL RECORD

COMPANY Cities Service Oil Company WELL # 1 FARM Campbell "D"  
 LOCATION 990' North & 990" West of E/4 Cor., Section 21, Township 29, Range 7W.  
 ELEV. 1550 CO. Kingman STATE Kansas  
 I.P. Dry hole. P. and A. December 30, 1959. ACID None  
 T.D. 4255' CONTRACTOR Barbour Drilling Company  
 DRIG. COMM. December 9, 1959 COMP. December 29, 1959

CASING RECORD:

8-5/8" at 397" with 250 sacks cement.

D.S.T. 4113-23, open 1 hr., 57 MCF gas in 6 mins., 22 MCF gas in 20 mins., stabilized; rec. 50' mud; BHP 1395# in 30 mins.

FORMATION RECORD:

red rock 0-40  
 red bed, shale and shells 398  
 red bed and shells 500  
 shale and shells 600  
 shale 900  
 Anhydrite 920  
 salt and shale 1200  
 shale and shells 1400  
 lime and shale 1540  
 shale and lime 2155  
 shale and lime shells 2390  
 shale and lime 2808  
 lime 2970  
 lime and shale 3140  
 shale and sand 3320  
 lime 3960  
 lime and shale 4020  
 shale and lime 4082  
 lime 4105  
 lime and shale 4111  
 chert 4165  
 lime and chert 4205  
 lime 4255-T.D.

D.S.T. 4123-33, open 1 hr., 109 MCF gas in 10 mins., 69 MCF in 20 mins., stabilized; rec. 60' mud; BHP 1450# in 30 mins.

D.S.T. 4133-43, open 1 hr., 44 MCF gas in 15 mins., decreased to too small to measure in 25 mins.; rec. 45' mud; BHP 1305# in 30 mins.

D.S.T. 4152-62, open 1 hr., rec. 88' oil spotted mud, 70' slightly oily watery mud, and 20' salt water; BHP 1230# in 30 mins.

D.S.T. 4222-42, open 1 hr., rec. 35' muddy water; BHP 1458# in 30 mins.

SLOPE TESTS (TOTCO):

150' - 1/2°	3075' - 1-3/4°
375' - 1°	3375' - 1 1/4°
500' - 1°	3490' - 1 1/4°
1000' - 1°	3580' - 1 1/4°
1390' - 1 1/4°	3825' - 1-3/4°
1630' - 1°	4095' - 1°
2380' - 1°	4215' - 1°

Heebner 3100  
 Douglas 3137  
 Lansing 3322  
 Base Kansas City 3821  
 Mississippi 4111  
 Pen. 444'  
 T.D. 4255

**RECEIVED**  
 STATE CORPORATION COMMISSION  
 JAN 15 1960  
 CONSERVATION DIVISION  
 Wichita, Kansas