

WELL PLUGGING RECORD

Give All Information Completely
Make Required Affidavit
Mail or Deliver Report to:
Conservation Division
State Corporation Commission
211 No. Broadway
Wichita, Kansas

Meade County. Sec. 36 Twp. 32 Rge. (E) 30 (W)

Location as "NE/CNW%SW%" or footage from lines C SW/4 NE/4

Lease Owner Peerless Oil & Gas Company

Lease Name Bachman Well No. 3

Office Address P. O. Box 245, Hooker, Oklahoma

Character of Well (completed as Oil, Gas or Dry Hole) Dry Hole

Date well completed June 12 19 57

Application for plugging filed June 12 19 57

Application for plugging approved June 12 19 57


Plugging commenced June 13, 1957 @ 12:30 a.m. 19

Plugging completed July 26 19 57

Reason for abandonment of well or producing formation Dry Hole

If a producing well is abandoned, date of last production _____ 19 _____

Was permission obtained from the Conservation Division or its agents before plugging was commenced? yes

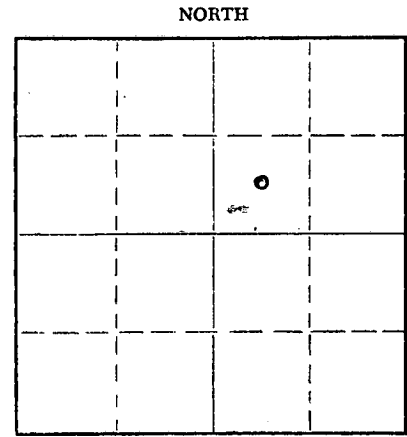

Locate well correctly on above Section Plat

Name of Conservation Agent who supervised plugging of this well R. J. Phillippe

Producing formation _____ Depth to top _____ Bottom _____ Total Depth of Well 584.8 Feet

Show depth and thickness of all water, oil and gas formations.

OIL, GAS OR WATER RECORDS

CASING RECORD

FORMATION	CONTENT	FROM	TO	SIZE	PUT IN	PULLED OUT
Tertiary Sand	Water	150'	500'	9 5/8"	1602'	None

Describe in detail the manner in which the well was plugged, indicating where the mud fluid was placed and the method or methods used in introducing it into the hole. If cement or other plugs were used, state the character of same and depth placed, from _____ feet to _____ feet for each plug set.

After logging well, hole filled with heavy mud. Set cement plug with drill pipe from 5254' to 5501' which consisted of 75 sacks of common cement. Set a top plug from 1528' to 1590' with 25 sacks of common cement. The top plug is near the bottom of the 9 5/8" casing. Cement pumped by Halliburton Cementers of Liberal, Kansas.

Officially plugged well by welding cap on top of 9 5/8" casing 4 feet below ground level. King's Welding Service of Guymon, Oklahoma, placed cap on well on July 26, 1957 at 10:00 a.m. Well officially plugged as of July 26, 1957.

Used 800 sacks of Pozmix #1 to cement 9 5/8" casing. Cement circulated on this casing making it impossible to pull any of the casing.

(If additional description is necessary, use BACK of this sheet)

Name of Plugging Contractor Midwestern Drillers

Address Liberal, Kansas

STATE OF Kansas, COUNTY OF Meade, ss.

Clyde W. Thompson (employee of owner) or (owner or operator) of the above-described well, being first duly sworn on oath, says: That I have knowledge of the facts, statements, and matters herein contained and the log of the above-described well as filed and that the same are true and correct. So help me God.

(Signature) Clyde W. Thompson General Superintendent

Peerless Oil & Gas Co., Box 245, Hooker, Okla. (Address)

SUBSCRIBED AND SWORN to before me this 5th day of August, 19 57

My Commission Expires Jan. 7, 1960

RECEIVED Notary Public. STATE CORPORATION COMMISSION

AUG 6 1957
08-06-57
CONSERVATION DIVISION
Wichita, Kansas

PLUGGING
FILE SEC 36 T. 32 R. 36w
BOOK PAGE 22 LINE 9

