


STATE OF KANSAS
STATE CORPORATION COMMISSION

WELL PLUGGING RECORD

Give All Information Completely
Make Required Affidavit
Mail or Deliver Report to
Conservation Division
State Corporation Comm.
245 North Water
Wichita, KS 67202

Greely County, Sec. 32 Twp. 17 Rge. 40 E/W
Location as "NE/CNW 1/4 SW 1/4" or footage from lines
640 FSU & EL of SW 1/4
Lease Owner Smith Cattle Co. Inc.
Lease Name Smith Cattle Co. Inc. Well No. 2
Office Address Tribune, Ks. 67879
Character of Well (Completed as Oil, Gas or Dry Hole)
Gas
Date Well completed 6-1-80 19
Application for plugging filed 8-4-80 19
Application for plugging approved 8-19-80 19
Plugging commenced 9-2-80 19
Plugging completed 9-4-80 19
Reason for abandonment of well or producing formation
Non commercial value
If a producing well is abandoned, date of last production
None 19
Was permission obtained from the Conservation Division or
its agents before plugging was commenced? yes
Name of Conservation Agent who supervised plugging of this well Mr. Balthazor
Producing formation F1 Riley Depth to top 2967 Bottom 2992 Total Depth of Well 3070
Show depth and thickness of all water, oil and gas formations.

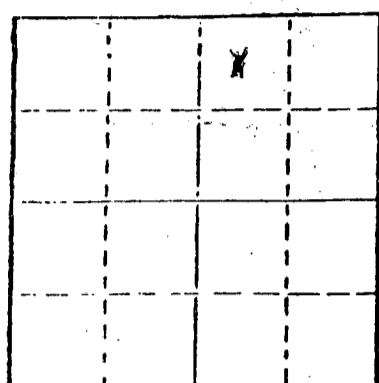

Locate well correctly on above
Section Plot

OIL, GAS OR WATER RECORDS

CASING RECORD

FORMATION	CONTENT	FROM	TO	SIZE	PUT IN	PULLED OUT
Surface				8 5/8"	255'	0'
Production				4 1/2"	3070'	2139'

Describe in detail the manner in which the well was plugged, indicating where the mud fluid was placed and the method or methods used in introducing it into the hold. If cement or other plugs were used, state the character of same and depth placed, from feet to feet for each plug set.

Pumped 1 sks. hulls & 10 sks. cement to 2900' pressured to 750 lbs.
Pumped 35 sks. cement 1000' to 880'
Displaced to 250'
Pumped 35 sks. 250' to 150'
Displaced to 40'
Put bridge 10 sks. 40' to 0'
Cut off 8 5/8" 3' below ground level

(If additional description is necessary, use BACK of this sheet)

Name of Plugging Contractor Midwest Casing Pulling Service, Box F, Sublette, Ks. 67877
Permit #766

STATE OF Kansas COUNTY OF Haskell
I, Edgar J. Eves (employee of owner) or (owner or operator)


of the above-described well, being first duly sworn on oath, says: That I have knowledge of the facts, statements, and matters herein contained and the log of the above-described well as filed and that the same are true and correct. So help me God.

(Signature) Edgar J. Eves
Box F, Sublette, Ks. 67877
(Address)

SUBSCRIBED AND SWORN TO before me this 5th day of Sept., 1980

Sondra L Eves
Notary Public.

My commission expires 12-6-80

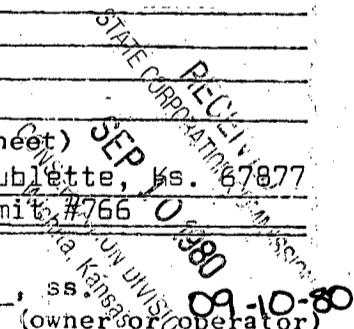

15-071-20190-00-00

Top of Cement 2200'

Rosel

WELL PERFORATORS, INC.

Nuclear Log

COMPANY	SMITH CATTLE COMPANY	
WELL	SMITH CATTLE COMPANY #2	
FIELD	BYERLY	
COUNTY	GREELY	STATE KANSAS
Location:	640' FS & EL SW/4 SEC. 32-175-40W	Order Service: BOND PERF.

Permanent Datum:	G.L.	3626	FILE NO. KR 3634
Log measured from:	K.B.	8	FE
Drilling measured from:	K.B.		GT 3626

Date	2-13-80
Run No.	ONE
Type Log	G/R-N-SPECTRA
Depth—Driller	3070
Depth—Logger	3023
Bottom logged interval	3022
Top logged interval	2000
Type fluid in hole	KCL
Salinity, PPM Cl.	
Density	
Level	600'
Max. rec. temp., deg F.	
Operating rig time	2 HRS.
Recorded by	BURNS
Witnessed by	M.R. OSTERBLUM

FIELD PRINT

RECEIVED
STATE CORPORATION COMMISSION
AUG 18 1980
CONSERVATION DIVISION
Topeka, Kansas

BORE-HOLE RECORD				CASING RECORD			
RUN No.	Bit	From	To	Size	Wgt.	From	To
1	7 7/8			8 7/8		0	257
				4 1/2		0	T.D.