

15-071-20158-00-00


STATE OF KANSAS  
STATE CORPORATION COMMISSION

WELL PLUGGING RECORD

Give All Information Completely  
Make Required Affidavit  
Mail or Deliver Report to  
Conservation Division  
State Corporation Comm.  
245 North Water  
Wichita, KS 67202

Greeley County, Sec. 31 Twp. 17 Rge. 40 E/W  
Location as "NE/CNW 1/4 SW 1/4" or footage from lines

990' FFI & 990' FNI  
Lease Owner R.C. Banks  
Lease Name Smith Company Well No. 1  
Office Address Box 242; Midland, Texas 79701  
Character of Well (Completed as Oil, Gas or Dry Hole)

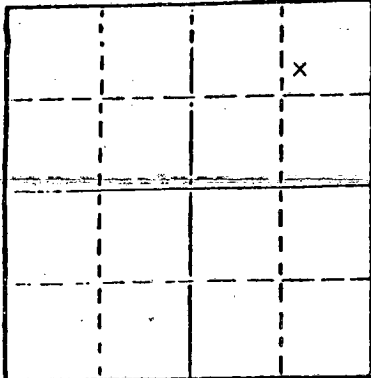

Locate well correctly on above  
Section Plat

Gas  
Date Well completed 9-16 1978  
Application for plugging filed 5-14 1979  
Application for plugging approved 5-15 1979  
Plugging commenced 5-16 1979  
Plugging completed 5-17 1979  
Reason for abandonment of well or producing formation  
Non Commercial Value  
If a producing well is abandoned, date of last production  
None 19

Was permission obtained from the Conservation Division or  
its agents before plugging was commenced? Yes

Name of Conservation Agent who supervised plugging of this well Mr. Balthazor  
Producing formation Winfield Depth to top 2956' Bottom 2964' Total Depth of Well 3047'  
Show depth and thickness of all water, oil and gas formations.

OIL, GAS OR WATER RECORDS

CASING RECORD

| FORMATION  | CONTENT | FROM | TO | SIZE   | PUT IN | PULLED OUT |
|------------|---------|------|----|--------|--------|------------|
| Surface    |         |      |    | 8 5/8" | 249'   | 0'         |
| Production |         |      |    | 4 1/2" | 3047'  | 2422'      |
|            |         |      |    |        |        |            |
|            |         |      |    |        |        |            |

Describe in detail the manner in which the well was plugged, indicating where the mud fluid  
was placed and the method or methods used in introducing it into the hold. If cement or other  
plugs were used, state the character of same and depth placed, from \_\_\_\_\_ feet to  
\_\_\_\_\_ feet for each plug set.

Pumped 1 sack of hulls & 15 sacks cement to 2810'-Pressured to 750 lbs.  
Displaced to 800'  
Pumped 25 sacks cement 800' to 700'  
Displaced to 250'  
Pumped 35 sacks cement 250' to 150'  
Displaced to 40'  
Put bridge & 10 sacks cement 40' to 0'  
Cut off 8 5/8" 3' below ground level.

RECEIVED  
STATE CORPORATION COMMISSION

MAY 25 1979 05-25-79

CONSERVATION DIVISION  
Wichita, Kansas

(If additional description is necessary, use BACK of this sheet)

Name of Plugging Contractor Midwest Casing Pulling  
Box F, Sublette, Kansas 67877 Kansas permit # 776

STATE OF KANSAS COUNTY OF HASKELL, ss.  
I Edgar J. Eves (employee of owner) or (owner or operator)

of the above-described well, being first duly sworn on oath, says: That I have knowledge of  
the facts, statements, and matters herein contained and the log of the above-described well  
as filed and that the same are true and correct. So help me God.

(Signature)

*Edgar J. Eves*  
Box F, Sublette, Kansas 67877  
(Address)

SUBSCRIBED AND SWORN TO before me this 17th day of May, 1979

*Sondra L. Eves*

Notary Public.

My commission expires 12-6-80

