


15-07-20148-00-00

STATE OF KANSAS
STATE CORPORATION COMMISSION

WELL PLUGGING RECORD

Give All Information Completely
Make Required Affidavit
Mail or Deliver Report to
Conservation Division
State Corporation Comm.
245 North Water
Wichita, KS 67202

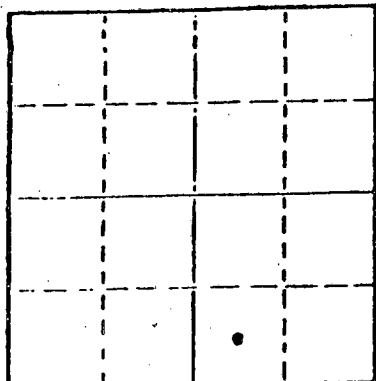

Locate well correctly on above
Section Plat

Greeley County. Sec. 24 Twp. 17 Rge. 40 E/W
Location as "NE/CNW $\frac{1}{4}$ SW $\frac{1}{4}$ " or footage from lines
660' FSL & 1980' FEL
Lease Owner Dorchester Exploration Inc.
Lease Name Wear "C" Well No. 1
Office Address 1100 Midland Nat'l Bk. Tower, Midland, Texas
Character of Well (Completed as Oil, Gas or Dry Hole) _____

Gas
Date Well completed January 27 19 78
Application for plugging filed 2-4-1978 1978
Application for plugging approved 2-7 1978
Plugging commenced 3-24 1978
Plugging completed 3-27 1978

Reason for abandonment of well or producing formation _____
Non Commercial Value
If a producing well is abandoned, date of last production _____
None 19 _____

Was permission obtained from the Conservation Division or its agents before plugging was commenced? Yes

Name of Conservation Agent who supervised plugging of this well Mr. Balthazor
Producing formation Hugoton Depth to top 2962' Bottom 2990' Total Depth of Well 3080'
Show depth and thickness of all water, oil and gas formations.

OIL, GAS OR WATER RECORDS

CASING RECORD

FORMATION	CONTENT	FROM	TO	SIZE	PUT IN	PULLED OUT
Surface		0'	301'	8 5/8"	301'	0'
Production		0'	3078'	4 1/2"	3078'	2175'

Describe in detail the manner in which the well was plugged, indicating where the mud fluid was placed and the method or methods used in introducing it into the hold. If cement or other plugs were used, state the character of same and depth placed, from _____ feet to _____ feet for each plug set.

Pumped 1 Sack hulls & 10 Sacks cement to 2850' pressured to 750 lbs.
Displaced w/ mud 2850' to 1000'
Pumped 25 sacks cement 1000' to 920'
Displaced w/ mud 920' to 300'
Pumped 25 sacks cement 300' to 220'
Displaced w/ mud 220' to 45'
Put bridge & 15 sacks cement 45' to 0'.
Cut off 8 5/8" 42" below ground level.

RECEIVED
STATE CORPORATION COMMISSION
APR 05 1978
04-05-78
CONSERVATION DIVISION
Wichita, Kansas

(If additional description is necessary, use BACK of this sheet)

Name of Plugging Contractor Midwest Casing pulling
Box F, Sublette, Kansas 67877 Permit # 766

STATE OF KANSAS COUNTY OF Haskell, ss.
I Edgar J. Eves (employee of owner) or (owner or operator)

of the above-described well, being first duly sworn on oath, says: That I have knowledge of the facts, statements, and matters herein contained and the log of the above-described well as filed and that the same are true and correct. So help me God.

(Signature) Edgar J. Eves
Box F, Sublette, Kansas 67877
(Address)

SUBSCRIBED AND SWORN TO before me this 29th day of March, 1978

Sandra L. Eves
Notary Public.

My commission expires 12-6-80

