


STATE OF KANSAS  
STATE CORPORATION COMMISSION

WELL PLUGGING RECORD

Give All Information Completely  
Make Required Affidavit  
Mail or Deliver Report to  
Conservation Division  
State Corporation Comm.  
245 North Water  
Wichita, KS 67202

Greeley County, Sec. 35 Twp. 19S Rge. 39 XE/W  
Location as "NE/CNW $\frac{1}{4}$ SW $\frac{1}{4}$ " or footage from lines

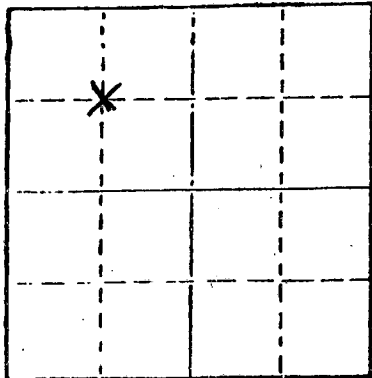

Locate well correctly on above Section Plat

C NW/4  
Lease Owner Cities Service Company  
Lease Name Nickelson A Well No. 1  
Office Address 3545 N.W. 58th St., Okla. City, OK 73112  
Character of Well (Completed as Oil, Gas or Dry Hole) Dry Hole

Date Well completed 6-2-1982  
Application for plugging filed 5-12-1982  
Application for plugging approved 5-17-1982  
Plugging commenced 6-1-1982  
Plugging completed 6-2-1982

Reason for abandonment of well or producing formation DRY HOLE

If a producing well is abandoned, date of last production 19

Was permission obtained from the Conservation Division or its agents before plugging was commenced? Yes

Name of Conservation Agent who supervised plugging of this well Clarence Thomas  
Producing formation None Depth to top          Bottom          Total Depth of Well 2930'  
Show depth and thickness of all water, oil and gas formations.

OIL, GAS OR WATER RECORDS

CASING RECORD

| FORMATION | CONTENT  | FROM  | TO    | SIZE   | PUT IN | PULLED OUT |
|-----------|----------|-------|-------|--------|--------|------------|
| Winfield  | Dry Hole | 2825' | 2832' | 8-5/8" | 411'   | None       |
|           |          |       |       | 4-1/2" | 2929'  | 1530'      |

Describe in detail the manner in which the well was plugged, indicating where the mud fluid was placed and the method or methods used in introducing it into the hold. If cement or other plugs were used, state the character of same and depth placed, from          feet to          feet for each plug set.

Set CIBP @ 2815' w/9' cmt plug on top of CIBP to 2806'. Shot 4-1/2 csg off at 1532' came free. Spotted 25 sx cmt plug from 1532-1460'. Spotted 40 sx cmt plug from 460-360'. Pulled csg. Spotted 10 sx. cmt plug from 40-4' below surface - welded plate on 8-5/8" csg w/name and date.


(If additional description is necessary, use BACK of this sheet)

Name of Plugging Contractor Daco, Inc.

STATE OF Oklahoma COUNTY OF Oklahoma, ss.  
Verlin Meier (employee of owner) or (owner or operator)  
of the above-described well, being first duly sworn on oath, says: That I have knowledge of the facts, statements, and matters herein contained and the log of the above-described well as filed and that the same are true and correct. So help me God.

(Signature) Verlin Meier  
3545 N.W. 58th Okla. City, OK 73112  
(Address)

SUBSCRIBED AND SWORN TO before me this 16<sup>th</sup> day of June, 19 82

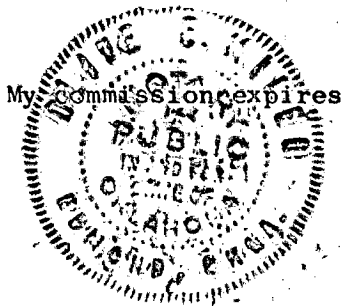

July 10, 1982

Oliver E. Meier  
Notary Public.

RECEIVED  
STATE CORPORATION COMMISSION  
JUN 17 1982  
06-17-82  
CONSERVATION DIVISION  
Wichita Kansas

JOHNSON

Drilling Company, Inc.

15-071-20234-00-00



OFFICES IN

EVANSVILLE, INDIANA  
TEL. (812) 424-8291

OKLAHOMA CITY, OKLAHOMA  
TEL. (405) 943-7667

LIBERAL, KANSAS  
TEL. (316) 624-7731

REPLY TO:

3535 N.W. 58th - Suite 710  
Oklahoma City, Oklahoma 73112

CITIES SERVICE COMPANY  
P.O. BOX 686  
ULYSSES, KANSAS 67880

ATTN: J.K. RUSSELL

DRILLERS LOG FOR: NICKELSON "A" #1

|               |                         |
|---------------|-------------------------|
| 0' - 412'     | Surface, clay, and sand |
| 412' - 2150'  | Shale and Sandy shale   |
| 2150' - 2930' | Lime and shale          |

JOHNSON DRILLING COMPANY

Signed by:

CLAUDE D. MOORE - MANAGER

STATE OF OKLAHOMA  
COUNTY OF OKLAHOMA

Subscribed and sworn to before me this 14th day of May, 1981.

Elizabeth Clark

NOTARY PUBLIC

My Commission Expires:

7/6/83

RECEIVED  
STATE CORPORATION COMMISSION

MAY 17 1982

CONSERVATION DIVISION  
Wichita, Kansas