


STATE OF KANSAS
STATE CORPORATION COMMISSION

WELL PLUGGING RECORD

Give All Information Completely
Make Required Affidavit.
Mail or Deliver Report to
Conservation Division
State Corporation Comm.
245 North Water
Wichita, KS 67202

Greeley County, Sec. 27 Twp. 19S Rge. 39 E/W
Location as "NE/CNW $\frac{1}{4}$ SW $\frac{1}{4}$ " or footage from lines
C SW/4

Lease Owner Cities Service Company
Lease Name Chisholm A Well No. 1
Office Address 3545 N.W. 58th Street - Okla. City, OK 73112
Character of Well (Completed as Oil, Gas or Dry Hole) DRY HOLE

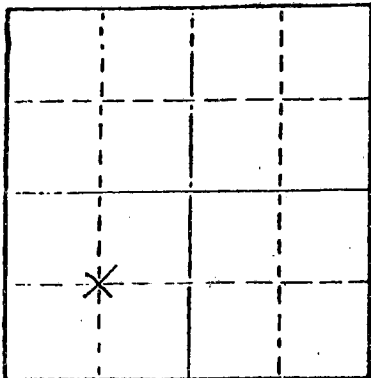

Locate well correctly on above
Section Plot

Date Well completed 5-26 1982
Application for plugging filed 5-12 1982
Application for plugging approved 5-17 1982
Plugging commenced 5-24 1982
Plugging completed 5-26- 1982
Reason for abandonment of well or producing formation DRY HOLE

If a producing well is abandoned, date of last production 19

Was permission obtained from the Conservation Division or its agents before plugging was commenced? Yes

Name of Conservation Agent who supervised plugging of this well Clarence Thomas
Producing formation None Depth to top Bottom Total Depth of Well 2940'
Show depth and thickness of all water, oil and gas formations.

OIL, GAS OR WATER RECORDS

CASING RECORD

FORMATION	CONTENT	FROM	TO	SIZE	PUT IN	PULLED OUT
Winfield	Dry	2835'	2842'	8-5/8"	405'	None
				4-1/2"	2939	1720'

Describe in detail the manner in which the well was plugged, indicating where the mud fluid was placed and the method or methods used in introducing it into the hold. If cement or other plugs were used, state the character of same and depth placed, from feet to feet for each plug set.

Set CIBP at 2825' w/9' cmt on top of plug. Shot off 4-1/2" csg at 1720', came free. Set 25 sx plug from 1720-1648'. Pulled csg to 450'. Spot 50 sx. plug from 450-350'. Pulled to 40'. 45 Spot 10 sx plug from 40-44.5 below surface.

(If additional description is necessary, use BACK of this sheet)

Name of Plugging Contractor Daco, Inc.

STATE OF Oklahoma COUNTY OF Oklahoma, ss.
Verlin Meier (employee of owner) or (owner or operator)

of the above-described well, being first duly sworn on oath, says: That I have knowledge of the facts, statements, and matters herein contained and the log of the above-described well as filed and that the same are true and correct. So help me God.

(Signature) Verlin Meier

3545 N.W. 58th Street - Okla. City, OK 73112
(Address)

SUBSCRIBED AND SWORN TO before me this 14th day of June, 1982

Joyce L. Porter
Notary Public.

My commission expires 6-10-84

RECEIVED
STATE CORPORATION COMMISSION

JUN 17 1982
06-17-82
CONSERVATION DIVISION
Wichita Kansas

15-071-20230-00-00

JOHNSON *Drilling Company, Inc.*



OFFICES IN
EVANSVILLE, INDIANA
TEL. (812) 424-8291
OKLAHOMA CITY, OKLAHOMA
TEL. (405) 943-7667
LIBERAL, KANSAS
TEL. (316) 624-7731

REPLY TO:
3535 N.W. 58th, Suite 710
Oklahoma City, Oklahoma 73122

April 30, 1981

CITIES SERVICE COMPANY
P.O. BOX 686
ULYSSES, KANSAS 67880

CHISHOLM A - 1

ATTN: J.K. RUSSELL

Drillers Log for;

0' - 406'	Surface, clay and sand
406' - 1355'	Shale and sandy shale
1355' - 2940'	Lime and Shale

JOHNSON DRILLING COMPANY

Signed By: *Claude D. Moore*
Claude D. Moore - Manager

STATE OF OKLAHOMA
COUNTY OF OKLAHOMA

Subscribed and sworn to before me this 30th day of April, 1981.

Lawrence P. Foley NOTARY PUBLIC

My Commission Expires: *October 24, 1984*

RECEIVED
STATE CORPORATION COMMISSION

MAY 17 1982

CONSERVATION DIVISION
Wichita Kansas