


15-071-20260-00-00

WELL PLUGGING RECORD

Give All Information Completely
 Make Required Affidavit

COUNTY Greely SEC. 23 TWP. 19 RGE. 39 E/W
 Location as in quarters or footage from lines:
C-SW 1/4

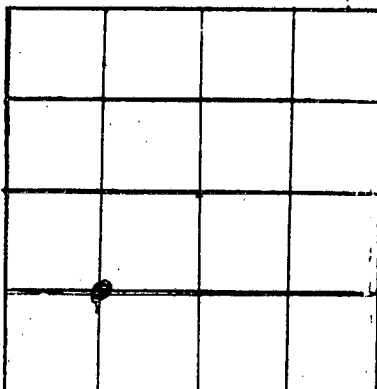

Lease Owner Westburn Petroleum Co.
 Lease Name Koci West Well No. 1-23
 Office Address 308 One Denver Place, Denver CO 80202
 Character of Well (Completed as Oil, Gas or Dry Hole): gas
 Date Well Completed _____
 Application for plugging filed _____
 Plugging commenced 11-1-1983
 Plugging completed 11-1-1983
 Reason for abandonment of well or producing formation
Non Commercial Value

Locate Well
 correctly on above
 Section Platt.

Was permission obtained from the Conservation Division or it's
 Agent's before plugging was commenced? yes

Name of Conservation Agent who supervised plugging of this well Mr. Luthi
 Producing formation _____ Depth to top 2882 bottom 2892 T.D. 3207'
 Show depth and thickness of all water, oil and gas formations.


OIL, GAS OR WATER RECORDS

Casing Record

Formation	Content	From	To	Size	Put in	Pulled Out
Surface				8 5/8"	305'	0'
Production				4 1/2"	3207'	472'

Describe in detail the manner in which the well was plugged, indicating where the mud
 fluid was placed and the method or methods used in introducing it into the hold. If cement
 or other plugs were used, state the character of same and depth placed, from _____ feet
 to _____ feet for each plug set.

Pump 1 sk. hulls - 25 sks. cement to 2520'
 Displaced to 1900' & pumped 25 sks. cement 1900' to 1600' pressured to 750 lbs.
 Shot off 4 1/2" @ 472' & pumped 50 sks. cement 360' to 210'
 Put bridge & 10 sks. cement 40' to 0'
 Cut off 8 5/8", 3' below ground level & weld plate on same.

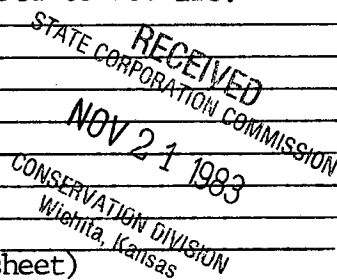

(If additional description is necessary, use BACK of this sheet)
 Name of Plugging Contractor Midwest Casing Pulling Service
 Lic. # 6497

STATE OF KANSAS COUNTY OF HASKELL, ss.
I, Edgar J. Eves (~~employee of owner~~) or (owner or operator) of the
 above-described well, being first duly sworn on oath, says: That I have knowledge of the
 facts, statements, and matters herein contained and the log of the above-described well as
 filed and that the same are true and correct. So help me God.

(Signature) Edgar J. Eves
 Box F, Sublette, KS. 67877
 (Address)

SUBSCRIBED AND SWORN TO before me this 9th day of Nov., 1983

Sandra L Eves
 Notary Public.

My Commission expires: 12-6-84

