

FORM MUST BE TYPED

FORM C-1 12/88

EFFECTIVE DATE: 4/18/90

NOTICE OF INTENTION TO DRILL

MUST BE SIGNED

Must be approved by the K.C.C. five (5) days prior to commencing well

ALL BLANKS MUST BE FILLED

Expected Spud Date 05/01/90
month day yearE2NWSW ... SW Sec ... 32 Twp ... 34 S, Rg ... 10 EE East WestOPERATOR: License # 3737
Name: ED SMITH
Address: 789 CLIFTON
City/State/Zip: CLIFTON NJ 07013
Contact Person: P. J. BUCK
Phone: (316) 725-3636..... 990 feet from South line of Section
..... 5115 feet from East line of Section
(Note: Locate well on Section Plat Below)CONTRACTOR: License # 5831
Name: M. O. K. A. J. DRILLINGCounty: CHANTAWQUA
Lease Name: SMITH Well #: 100-A
Field Name: SEDAN
Is this a Prorated field? yes XX no
Target Formation(s): MISSISSIPPI CHAT
Nearest lease or unit boundary: 1485 ✓
Ground Surface Elevation: 980 TQPD feet MSL
Domestic well within 330 feet: yes XX no
Municipal well within one mile: yes XX no
Depth to bottom of fresh water: 200
Depth to bottom of usable water: 500
Surface Pipe by Alternate: 1 XX 2
Length of Surface Pipe Planned to be set: 40
Length of Conductor pipe required: *****
Projected Total Depth: 2200
Formation at Total Depth: MISSISSIPPI CHAT
Water Source for Drilling Operations:
... well XX farm pond otherDWR Permit #:
Will Cores Be Taken?: yes XX no
If yes, proposed zone:Well Drilled For: Well Class: Type Equipment:
XX Oil ... Inj ... Infield ... Mud Rotary
XX Gas ... Storage XX Pool Ext. XX Air Rotary
XX OWD ... Disposal ... Wildcat ... Cable
... Seismic; ... # of Holes

If OWD: old well information as follows:

Operator: ED SMITH
Well Name: SMITH 100-A
Comp. Date: 03/31/90 Old Total Depth 1100Directional, Deviated or Horizontal wellbore? yes XX no
If yes, total depth location:

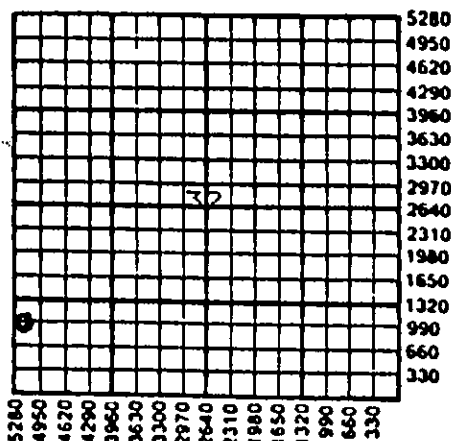
AFFIDAVIT

The undersigned hereby affirms that the drilling, completion and eventual plugging of this well will comply with K.S.A. 55-101, et. seq.

It is agreed that the following minimum requirements will be met:

1. The appropriate district office shall be notified before setting surface pipe;
2. The minimum amount of surface pipe as specified above shall be set by circulating cement to the top; in all cases surface pipe shall be set through all unconsolidated materials plus a minimum of 20 feet into the underlying formation;
3. If the well is dry, a plugging proposal shall be submitted to the district office. An agreement between the operator and the district office on plug length and placement is necessary prior to plugging;
4. The appropriate district office will be notified before well is either plugged or production casing is cemented in;
5. If an Alternate II completion, production pipe shall be cemented from below any usable water to surface within 120 days of spud date. In all cases, notify district office prior to any cementing.

I hereby certify that the statements made herein are true and to the best of my knowledge and belief.

Date: 04/12/90 Signature of Operator or Agent: [Signature] Title: AGENT

RECEIVED
STATE OF KANSAS
APR 13 1990
CONSERVATION DIVISION
Wichita, Kansas

FOR KCC USE:

API # 15- 019-25,929-A
 Conductor pipe required NONE feet
 Minimum surface pipe required 40 feet per Alt. X2
 Approved by: BGF 4/13/90
 EFFECTIVE DATE: 4/13/90
 This authorization expires: 10/13/90 EXT. 9
 (This authorization void if drilling not started within 6 months of effective date.)
 Spud date: _____ Agent: _____

REMEMBER TO:

- File Drill Pit Application (form CDP-1) with Intent to Drill;
- File Completion Form ACO-1 within 120 days of spud date;
- File acreage attribution plat according to field proration orders;
- Notify appropriate district office 48 hours prior to workover or re-entry;
- Submit plugging report (CP-4) after plugging is completed;
- Obtain written approval before disposing or injecting salt water.