


STATE OF KANSAS
STATE CORPORATION COMMISSION

Give All Information Completely
Make Required Affidavit
Mail or Deliver Report to:
Conservation Division
State Corporation Commission
212 North Market, Insurance Bldg.
Wichita, Kansas

WELL PLUGGING RECORD

Edwards County, Sec. 14 Twp. 26S (E) 16 (W)

Location as "NE/CNW/SW" or footage from lines C SW/4 SW/4
Lease Owner Skelly Oil Company
Lease Name C. W. Johnson Well No. 1
Office Address Box 1650, Tulsa, Oklahoma
Character of Well (completed as Oil, Gas or Dry Hole) Oil & Gas
Date well completed May 27, 19 59
Application for plugging filed April 7, 19 61
Application for plugging approved April 14, 19 61
Plugging commenced April 18, 19 61
Plugging completed April 22, 19 61
Reason for abandonment of well or producing formation Depleted

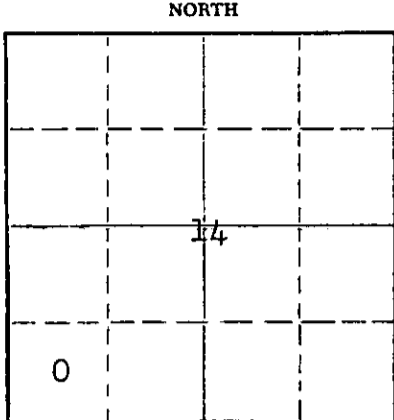

Locate well correctly on above Section Plat

If a producing well is abandoned, date of last production April 7, 1961
Was permission obtained from the Conservation Division or its agents before plugging was commenced? Yes

Name of Conservation Agent who supervised plugging of this well Mr. Frank Broadfoot
Producing formation Conglomerate Depth to top 4391' Bottom Total Depth of Well 4500 Feet
Show depth and thickness of all water, oil and gas formations. PB 4448'

OIL, GAS OR WATER RECORDS

CASING RECORD

| FORMATION | CONTENT | FROM | TO | SIZE | PUT IN | PULLED OUT |
|--------------|-----------|-------|-------|--------|---------|------------|
| Conglomerate | OIL & gas | 4392' | 4422' | 8-5/8" | 1053'6" | None |
| | | | | 5-1/2" | 4527'3" | 3358' |
| | | | | | | |
| | | | | | | |
| | | | | | | |
| | | | | | | |

Describe in detail the manner in which the well was plugged, indicating where the mud fluid was placed and the method or methods used in introducing it into the hole. If cement or other plugs were used, state the character of same and depth placed, from feet to feet for each plug set.

- Sand 4448' to 4380'
- 5 sacks of cement 4380' to 4340'
- Heavy mud 4340' to 240'
- Rock bridge and Halliburton plug 240' to 230'
- 20 sacks of cement 230' to 170'
- Mud 170' to 40'
- Rock bridge and Halliburton plug 40' to 30'
- 10 sacks of cement 30' to 4'
- Surface soil 4' to Surface

RECEIVED
STATE CORPORATION COMMISSION

MAY 8 1961

CONSERVATION DIVISION
Wichita, Kansas


(If additional description is necessary, use BACK of this sheet)
Name of Plugging Contractor Ace Pipe Pulling Company
Address P. O. Box 304, Great Bend, Kansas

STATE OF Kansas, COUNTY OF Reno, ss.
H. E. Wamsley (employee of owner) or (owner) of the above-described well, being first duly sworn on oath, says: That I have knowledge of the facts, statements, and matters herein contained and the log of the above-described well as filed and that the same are true and correct. So help me God.

(Signature) [Signature]
Box 391, Hutchinson, Kansas (Address)

SUBSCRIBED AND SWORN TO before me this 5th day of May, 19 61

My commission expires April 7, 1963 [Signature] Notary Public.

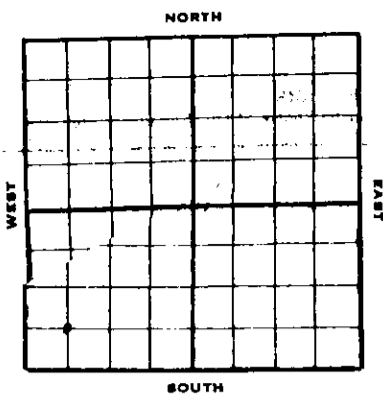

SKELLY OIL COMPANY

Well Record #51388

2073°DF
2071°GR
2060°LH

Lease Name and No. **C. W. Johnson** Well No. **1** Elev. **2060°LH**
 Lease Description **3/2 Section 14-26S-16E, Edwards County, Kansas (320 Acres)**
 Location made **March 24, 19 59** by **F. O. Morris**
 feet from North line **660** feet from East line **52 1/2**
 feet from South line **660** feet from West line of **Sec. 14**

Work com'd. **3/26** 19 **59** Rig com'p'd. **3/27** 19 **59** Drlg. com'd. **3/27** 19 **59** Drlg. com'p'd. **4/18** 19 **59**

Rig Contractor **Claude Wentworth Drlg. Co., Inc.**
 Drilling Contractor **Claude Wentworth Drlg. Co., Inc., Tulsa, Oklahoma**
 Rotary Drilling from **0°** to **4500°** Cable Tool Drilling from **To complete** to

Commenced Producing **May 27, 19 59** Initial Prod. before shot or acid **Failed 18 GPPH** Bbls.
 Initial Prod. after shot or acid **Flowed 24 hrs. thru 2" 10 7/8 in.** Bbls.

Dry Gas Well Press **0°** Volume **349,000** Cu. ft.

Casing Head Gas Pressure **PTP-60°, PCP-200°** Volume **349,000** Cu. ft.

Braden Head (**8-5/8" x 5 1/2" OD**) Gas Pressure Volume Cu. ft.

Braden Head () Gas Pressure Volume Cu. ft.

PRODUCING FORMATION **Conglomerate** Top **4392°** Bottom **4422°** TOTAL DEPTH **4500°** PE **1.448°**

CASING RECORD

| Casing Size | Wt. | Thds. | Where Set | PULLED OUT | | | LEFT IN | | | KIND | Cond'n | CEMENTING | |
|--|-----|-------|-----------|------------|------|-----|---------|------|-----|----------|--------|------------|------------------|
| | | | | Jts. | Feet | In. | Jts. | Feet | In. | | | Sacks Used | Method Employed |
| 8-5/8" 22.7 | 33 | 1060° | | | | | 27 | 1053 | 6 | Arco SW | A | 550 | Hallib. 1053°-6° |
| 5-1/2" 14.6 | 38 | 4499° | | | | | 136 | 4427 | 3 | 55 R3 SS | A | 175 | Hallib. 4497°-6° |
| (8-5/8" casing set 4 1/2" below ground and 5 1/2" set 1 1/2" above ground) | | | | | | | | | | | | | |

5 1/2" casing perforations open:
 Above PE TD: **4392°-4422°** with 181 holes
 Below PB TD: **4462°-64°** with 12 holes, and **4466°-68°** with 12 holes

Liner Set at _____ Length _____ Perforated at _____
 Liner Set at _____ Length _____ Perforated at _____

Packer Set at _____ Size and Kind _____

Packer Set at _____ Size and Kind _____

SHOT OR ACID TREATMENT RECORD

| | FIRST | SECOND | THIRD | FOURTH |
|-------------------------------------|------------------------------|------------------------------|------------------------------|--------------------|
| Date | 4/24/59 | 4/27/59 | 4/28/59 | |
| Acid Used | 500 Gals. | 500 Gals. | | |
| Size Shot | 8x | 8x | | |
| Shot Between | 4462 Ft. and 4468 Ft. | 4392 Ft. and 4422 Ft. | 4392 Ft. and 4422 Ft. | Ft. and Ft. |
| Size of Shell | | | Vis-O-Frac | |
| Put in by (Co.) | Halliburton | Halliburton | Halliburton | |
| Length anchor | | | | |
| Distance below Cas'g | | | | |
| Damage to Casing or Casing Shoulder | | | | |

RECEIVED
STATE CORPORATION

SIGNIFICANT GEOLOGICAL FORMATIONS

| NAME | Top | Bottom | GAS | | OIL | | REMARKS |
|-------------------------|--------------|--------|------|----|--------------------|-------------------------------|---------|
| | | | From | To | From | To | |
| Hoebner Shale | 3755° | | | | | | |
| Lansing Line | 3919° | | | | | | |
| Cherokee Line | 4372° | | | | | | |
| Conglomerate Sd. | 4391° | | | | 4392° 4422° | Prod. thru casg. perf. | |
| Kinderhook | 4423° | | | | | | |
| Viola Line | 4462° | | | | | | |

CONSERVATION DIVISION
MAY 5 1959

CLEANING OUT RECORDS

| | DATE COMMENCED | DATE COMPLETED | PROD. BEFORE | PROD. AFTER | REMARKS |
|-----|----------------|----------------|--------------|-------------|--------------------------------|
| 1st | | | | | See Reverse for other details. |
| 2nd | | | | | " " " " " |
| 3rd | | | | | " " " " " |
| 4th | | | | | " " " " " |

PLUGGING BACK AND DEEPENING RECORDS

| | Date Commenced | Date Completed | No. Feet Plugged Back or Deepened | Prod. Before | Prod. After | REMARKS |
|-----|----------------|----------------|-----------------------------------|--------------|-------------|--------------------------------|
| 1st | | | | | | See Reverse for other details. |
| 2nd | | | | | | " " " " " |
| 3rd | | | | | | " " " " " |
| 4th | | | | | | " " " " " |

(See Reverse for Record of Formation)

RECORD OF FORMATIONS

| FORMATION | TOP | BOTTOM | REMARKS Indicate Casing Points, Describe Shows of Oil, Gas and Water, etc. |
|---|------|--------|--|
| Surface soil, shale, and red beds | 0 | 390 | |
| Shale, red bed and shell | 390 | 755 | |
| Shale and shells | 755 | 932 | |
| Shale | 932 | 1030 | |
| Shale, shells and anhydrite | 1030 | 1061 | <u>TOP ANHYDRITE 1054°</u> Set and cemented 8-5/8"OD, 22.7#, Araco S.A., S.J. steel casing (A cond.) at 1060° with 550 sacks of Pozmix cement. Cement circulated. |
| Anhydrite | 1061 | 1080 | |
| Shale and shells | 1080 | 1590 | |
| Shale | 1590 | 1915 | |
| Shale and lime | 1915 | 2247 | |
| Lime | 2247 | 2320 | |
| Lime and shale | 2320 | 3570 | |
| Lime | 3570 | 3625 | |
| Lime and shale | 3625 | 3929 | <u>TOP HEEBER SHALE 3755°</u> <u>TOP FROWN LIME 3902°</u> <u>TOP LANSING LIME 3919°</u> |
| Buff, finely crystalline dense lime | 3929 | 3938 | No shows |
| Green to buff, finely crystalline lime, slightly fossiliferous | 3938 | 3954 | Fair vuggy porosity, spotted light stain with very small show of free oil. |
| Light tan, finely crystalline, very dense lime | 3954 | 3960 | No shows Ran Halliburton drill stem test No. 1, packer set at 3929°, used 31° anchor, open 1 hour, good blow throughout test, recovered 155° of heavy gas cut mud with few specks of oil and 130° of salt water, IHP-142#, in 20 mins., IFF-50#, FFP-150#, FHP-1100# in 20 minutes. |
| Lime | 3960 | 4368 | <u>BASE KANSAS CITY LIME 4206°</u> <u>TOP CHEROKEE LIME 4372°</u> |
| Light gray sand, fair grained, sub-angular | 4368 | 4388 | Fair porosity, fair gilsonitic, good black stain, no show of free oil. Ran Halliburton drill stem test No. 2, packer set at 4368°, used 20° anchor, open 1 hour, weak blow for 10 mins. recovered 5° of drilling mud, IHP-27# in 20 mins., IFF-15#, FFP-13#, FHP-13# in 20 mins. |
| Lime, sand and shale | 4388 | 4390 | <u>TOP CONGLOMERATE SAND 4391°</u> |
| Tan, fine grained, sub-angular, quartzitic sand with vari-colored slightly weathered chert | 4390 | 4413 | Fair spotted light stain, well sorted porosity, no free oil. Ran Halliburton drill stem test No. 3, packer set at 4388°, used 25° anchor, open 1 hour, gas to surface in 4 minutes, gas gauged 340 MCF, recovered 70° of gas cut mud, IHP-139# in 20 mins., IFF-55#, FFP-65#, FHP-1299# in 20 mins. |
| White, sub-opalescent chert with fine grained angular sand inclusions, sand grained, disseminated | 4413 | 4433 | <u>TOP LINDENBROOK 4421°</u> Poor spotted brown stain with fair show of free oil with yellow vari-colored pink chert with fair black stain, trace of heavy free oil. |

| | | |
|---|---------------------|---|
| <p>Vari-colored, light green translucent to opaque chert</p> | <p>4433 4455</p> | <p>Run Halliburton drill stem test No. 4, packer set at 4413', used 20' anchor, open 1 hour, gas to surface in 55 minutes, too small to gauge, recovered 30' oil and gas cut mud, 55' heavy oil and gas cut mud, 100' gassy oil, 4' fresh filtered water, IHP-1405% in 20 mins., IFF-55%, FFP-83%, FEHP-1193% in 20 mins.</p> <p>Very poor spotted stain with brown vari-colored silty shale, slightly sandy.</p> |
| <p>Line and chert Light buff, sub-opaque chert, white-buff coarsely crystalline dense chert</p> | <p>4455 4462</p> | <p>Run Halliburton drill stem test No. 5, packer set at 4433', used 22' anchor, open 1 hour, weak blow for 5 mins., recovered 3' of mud, IHP-135% in 20 mins., IFF-27%, FFP-27%, FEHP-40% in 20 mins. <u>TOP VIOLA LINE 4462'</u></p> |
| <p>White, slightly weathered, sub-opaque chert</p> | <p>4462 4470</p> | <p>No shows</p> |
| <p>White, slightly weathered, sub-opaque chert</p> | <p>4470 4477</p> | <p>Fair to poor vuggy porosity, fair spotted stain with trace of free oil in wet sample and light tan, fine grained dolomite, fair porosity, no shows.</p> |
| <p>White opaque chert, slightly tripelitic</p> | <p>4477 4480</p> | <p>Vuggy porosity, poor permeability, fair show of light oil, samples bleeding oil freely.</p> |

RECEIVED
 STATE CORPORATION COMMISSION
 MAY 6 1959
 CONSERVATION DIVISION
 Wichita, Kansas

| | | |
|-----------------------|---------------------|---|
| <p>Chert and line</p> | <p>4480 4500</p> | <p>Run Halliburton drill stem test No. 6, packer set at 4463', used 17' anchor, open 1 hour, recovered 60' oil specked mud, 60' of heavy oil and gas cut mud, 60' of gassy oil, 120' watery oil, 550' salt water, hydrostatic pressure 2335#, ILHP-1460#, IFF-120#, FFP-440#, FEHP-1300%.</p> <p>Run Schlumberger Survey</p> <p>Set and cemented 5 1/2" OD, 14#, 8R thd., R-3, J-55, S.S. casing (A cond.) at 4499' with 175 sacks of Pozmix cement. Finished cementing at 6:50 p.m. 4/19/59.</p> |
|-----------------------|---------------------|---|

TOTAL DEPTH 4500'

Total depth reached: 4/18/59

Rigged up cable tools, bailed and scrubbed the hole down to top of cement plug, 4458', on April 23, 1959. Drilled cement plug to 4489' and ran Lane-Wells Cement, Gamma Ray and Chlorinilog.

Casing Perforation No. 1 - Viola Line - 4462'-4468'

| | | |
|-------------|----------|--------------------------------------|
| 4462'-4464' | 12 holes | Bailed 3 hrs., 10 GPH with sea oil |
| 4466'-4468' | 12 holes | Bailed 3 hrs., 50 GWPH and 2 1/2 GPH |

Treated through 5 1/2" casing with 500 gallons of Halliburton 15% MCA acid as follows:

TREATMENT NO. 1 - Acidized between 4462° and 4468°

Treatment put in 4/24/59 by Halliburton, using 500 gallons of acid and 111 barrels of oil.

| TIME | CP | IP | REMARKS |
|----------|-------|----|-------------------|
| 7:35 pm | 100% | | Start acid |
| 7:39 pm | 200% | | Start flush |
| 7:48 pm | 500% | | Acid on formation |
| 9:56 pm | 1700% | | |
| 10:03 pm | 800% | | |
| 10:24 pm | 800% | | Finished flush |

Swabbed through 5 1/2" casing to bottom 3 hours, 111 barrels of oil used in treating and 22 barrels of acid and formation water. Then swabbed off bottom 1 hour, 4 barrels of fluid (est. 15% oil). On April 25, swabbed through 5 1/2" casing off bottom 23 hours, 18 barrels of formation oil and 87 barrels of water.

Set Lane-Wells bridging plug at 4456°. Swabbed and bailed the hole dry, then plugged back with 1 sack of Cal-Seal from 4456° to 4448°.

Casing Perforation No. 2 - Conglomerate - 4392°-4422°

| | | |
|-------------|-----------|--|
| 4414°-4422° | 50 holes | Failed 3 hrs. 18 GCFE w/ trace wtr. |
| 4392°-4414° | 131 holes | 50 MCF gas. Failed 10 hrs. 18 GCF w/ trace water |

Ran 2" tubing open end to 4394° and treated with 500 gallons of Halliburton MCA acid as follows:

TREATMENT NO. 2 - Acidized between 4392°-4422°

Treatment put in 4/27/59 by Halliburton, using 500 gallons of acid and 113 barrels of oil.

| TIME | CP | IP | REMARKS |
|----------|-------|----|---------------------|
| 12:36 pm | | | Start acid |
| 12:47 pm | 950% | | Acid on bottom |
| 1:11 pm | 800% | | |
| 1:13 pm | 650% | | |
| 1:15 pm | 1350% | | |
| 1:17 pm | 1500% | | Treatment completed |

Swabbed through 2" tubing to bottom 4 hours, 96 barrels of oil used in treating. Swabbed off bottom 10 hours, 17 barrels of oil used in treating and no water.

Treated with Halliburton Vis-O-Frac down annulus in 5 1/2" casing as follows:

TREATMENT NO. 3 - Vis-O-Frac between 4392° and 4422°

Used 6000% of sand
6000 gals. kerosene
130 barrels of regular crude oil to fill and flush
100 - 3/4" rubber balls
Maximum CP-2300%, minimum CP-2000%
Time 9 mins.
Injection rate: 17 barrels per minute

Swabbed through 2" tubing 6 hours, 128 barrels of oil used in treating. Well then flowed through 2" tubing 5 hours, 91 barrels of oil used in treating, gas gauged 820 MCF, FTP-160%, FCP-445%. Then flowed through 2" tubing 6 hours, 35 barrels of oil used in treating, gas gauged 820 MCF, FTP-140%, FCP-400%.

On April 29, flowed through 2" tubing 24 hours, 12 barrels of oil used in treating, 63 barrels of formation oil and 19 barrels of water, FTP-110%, FCP-360% at start of test, gas gauged 600 MCF at start of test, FCP-340% at end of test, gas gauged 463 MCF at end and flowing 3.34 barrels fluid per hour. On April 30, flowed through 2" tubing 24 hours, 60 barrels of oil and 8 barrels of water, gas gauged 463 MCF, FTP-90%, FCP-310%. Shut in 24 hours, SI CP-1030%, SI IP-1010%. Shut in to install tank battery.

On May 17, flowed through 2" tubing 24 hours, 51 barrels of oil and 12 barrels of water, gas gauged 495 MCF, FTP-60%, FCP-220%. On May 18, flowed through 2" tubing 24 hours, 49 barrels of oil and 5 barrels of water, gas gauged 441 MCF, FTP-60%, FCP-200%. On May 19, flowed through 2" tubing with 3/16" choke 24 hours, 2 1/2 barrels of oil and 3.34 barrels of water, gas gauged 221 MCF, FTP-500%, FCP-630%. On May 20, flowed through 2" tubing 24 hours, 3/16" choke, 6 barrels of oil and 2 1/2 barrels of water, gas gauged 221 MCF, FTP-540%, FCP-700%. On May 21, flowed through 2" tubing 24 hours, 1" choke, 52 barrels of oil and 2 1/2 barrels of water, gas gauged 395 MCF, FTP-60%, FCP-210%. On May 22, flowed through 2" tubing 24 hours, 1" choke, 43 1/2 barrels of oil

and 6½ barrels of water, gas gauged 395 MCF, FCP-210½, FTP-60½.
 On May 23, flowed through 2" tubing 24 hours, 1" choke, 23 barrels of oil and 8 barrels of water, gas gauged 395 MCF, FTP-60½, FCP-200½.
 On May 24, flowed through 2" tubing with 1" choke 24 hours, 23 barrels of oil and 8 barrels of water, gas gauged 395 MCF, FTP-60½, FCP-200½.
 On May 25, flowed through 2" tubing 24 hours, 1" choke, 20 barrels of oil and 6 barrels of water, gas gauged 395 MCF. On May 27, flowed through 2" tubing 24 hours, 1" choke, on State Corporation Commission potential test, 34 barrels of oil and 7½ barrels of water, gas gauged 349 MCF, FTP-60½, FCP-200½, to establish 24 hour S.C.C. potential of 34 barrels.

PLUGGED BACK TOTAL DEPTH 4448'

SLOPE TEST DATA

| <u>DEPTH</u> | <u>ANGLE OF DEFLECTION</u> |
|--------------|----------------------------|
| 250' | 1/4 Degree |
| 1000' | 3/4 " |
| 1200' | 1/4 " |
| 1500' | 0 " |
| 1750' | 3/4 " |
| 2250' | 1/4 " |
| 2750' | 1/4 " |
| 3000' | 1/4 " |
| 3500' | 1/4 " |
| 3750' | 1/4 " |

RECEIVED
 MAY 3 1955
 CONSERVATION DIVISION
 WICHITA, KANSAS

FRACTURE CONGLOMERATE

Date Commenced: November 20, 1959
 Date Completed: December 4, 1959

Plugged Back Total Depth: 4448'

Production Before: 4 barrels oil and 2 barrels water, no gas
 Production After: Flowed 24 hours, 8 barrels oil, 3 barrels water,
 340,000 cubic feet gas, FCP-160#, FTP-10#

5½" Casing Perforations Open:

Above PE TD: 4392'-4422' with 181 holes

Below FB TD: 4462'-4464'/12 holes, 4466'-4468'/12 holes

Producing Formations: Conglomerate

Moved in and rigged up cable tools of W. L. Copeland Drilling Company on November 20, 1959.

TREATMENT NO. 4 - Sand-Oil-Frac - 4392'-4422'

11/21/59 treated with Dowell Sand-Oil-Frac between 2" tubing and 5½" casing, used 26,000# of sand, 12,000 gallons of regular crude oil with 240 gallons of Dowell J-97, maximum CP-2300#, minimum CP-2250#, Time 21 minutes, rate of injection: 22 barrels per minute.

Swabbed through 2" tubing 5 hours, 104 barrels of oil used in treating. Well started flowing, flowed 9 hours, 97 barrels of oil used in treating. On November 22, flowed through 2" tubing 23 hours, 59½ barrels of oil used in treating, 8 barrels of formation water, and gas gauged 520 M.C.F., FCP-240#, FTP-12#. On November 23, flowed through 2" tubing 24 hours, 40 barrels of oil used in treating, 2 barrels formation water and gas gauged 627 M.C.F., CP-200#, TP-10#.

On November 24, flowed through 2" tubing 24 hours, 27½ barrels of oil used in treating, 4 barrels formation water, and gas gauged 520 M.C.F., FCP-190#, FTP-10#. On November 25, flowed through 2" tubing 24 hours, 20 barrels oil used in treating and 2 barrels formation water, gas gauged 520 M.C.F., FCP-195#, FTP-10#. On November 26, flowed through 2" tubing 24 hours, 19 barrels oil used in treating, 2 barrels formation water, gas gauged 510 M.C.F., FCP-180#, FTP-10#. On November 27, flowed through 2" tubing 24 hours, 17 barrels of oil used in treating, 3 barrels formation water and gas gauged 310 M.C.F., FCP-175#, FTP-10#. On November 28, flowed through 2" tubing 24 hours, 13 barrels of oil used in treating, 2 barrels of formation water, gas gauged 340 M.C.F., FCP-160#, FTP-10#. On November 29, flowed through 2" tubing 24 hours, 13 barrels of oil used in treating, 3 barrels formation water, gas gauged 340 M.C.F., FCP-160#, FTP-10#. On November 30, flowed through 2" tubing 24 hours, 10 barrels of oil used in treating, 3 barrels of formation oil, gas gauged 340 M.C.F., FCP-160#, FTP-10#. On December 1, flowed through 2" tubing 24 hours, 3 barrels oil and 2 barrels water, gas gauged 390 M.C.F., FCP-160#, FTP-10#. On December 2, flowed through 2" tubing 24 hours, 5 barrels of oil and 2 barrels of water, gas gauged 340 M.C.F., FCP-160#, FTP-10#. On December 3, flowed through 2" tubing 24 hours, 10 barrels of oil and 3 barrels of water, gas gauged 340 M.C.F., FCP-160#, FTP-10#. On December 4, flowed through 2" tubing 24 hours, 8 barrels of oil and 3 barrels of water, gas gauged 340 M.C.F., FCP-160#, FTP-10#.

RECEIVED
 STATE CORPORATION COMMISSION

MAY 3 1961

CONSERVATION DIVISION
 Wichita, Kansas

SKELLY OIL COMPANY

CHANGE IN WELL RECORD

Give complete description of all cleaning out, deepening, plugging back and fishing jobs, changes in casing, material lost in hole, etc, not recorded in original well record.

LEASE NAME C. W. Johnson
 SEC. 14 T. 26S R. 16W
 BLOCK _____ SURVEY _____

WELL NO. 1 DISTRICT Western Kansas
 COUNTY Edwards AFE NO. 6828
 STATE Kansas

TYPE OF WORK PLUG AND ABANDON WELL

Date commenced April 18, 1961 Date completed April 22, 1961
 Deepened from _____ to _____ Total Depth _____
 Plugged back from 4448' to Surface P.B.T.D. _____
 Cleaned out from _____ to _____
 Production before 0.42 bbls. oil 1 1/2 bbls. water 92.5 E cu. ft. gas.
 Production after _____ bbls. oil _____ bbls. water _____ cu. ft. gas.
 Tools owned by; Ace Pipe Pulling Company Kind used; _____ No. days rig time; 5
 Cost of Job \$ _____ Revised Estimated Payout (Mos.) _____

TREATMENT RECORD

| DATE | TYPE TREATMENT | INTERVAL TREATED | AMOUNT OF TREATMENT |
|------|----------------|------------------|---------------------|
| | | | |
| | | | |
| | | | |
| | | | |

CHANGES IN CASING RECORD

| STRINGS | SIZE | WHERE SET (Depth) | CEMENTING RECORD | | REMARKS |
|------------|------|----------------------|------------------|------------------------|------------|
| | | | Sacks Used | Top Cem't. Br'd. Casg. | |
| Production | | | | | |
| Liner | | | | | Top liner; |

| SIZE | WT. | THDS. | KIND | COND. | LEFT IN | | | | | | PULLED OUT | | | | | | | |
|-----------|------|-------|-----------|-------|---------|------|-----|------|------|-----|------------|------|------|-----|-----|------|-----|-----|
| | | | | | Jts. | Feet | LTM | In. | Feet | WTM | In. | Jts. | Feet | LTM | In. | Feet | WTM | In. |
| 5 1/2" OD | 14.7 | 8R | J55 R3 SS | E | 36 | 1139 | 6 | 1147 | 9 | 99 | 3324 | 0 | 3379 | 6 | | | | |
| 5 1/2" OD | 14.7 | 8R | J55 R3 SS | D | | | | | | 1 | 34 | 0 | | | | | | |

PRODUCING FROM

FORMATION _____ thru OPEN HOLE PERFORATIONS _____ TOP _____ BOTTOM _____ Total No. Shots _____

REMARKS (Give review of work performed and any other comment of interest)

As this well was no longer profitable to operate and as there were no other probable productive zones to test, regular authority was granted to plug and abandon it.

On April 18, 1961, moved in and rigged up plugging machine and plugged the well as follows:

Sand 4448' to 4380'
 5 sacks of cement 4380' to 4340'

Loaded hole with water and shot off 5 1/2" casing at 3400' and 3340', unable to pull casing. Spotted 40 barrels of oil behind 5 1/2" casing. Pulled 3358' of 5 1/2" casing.

Heavy mud 4340' to 240'
 Rock bridge and Halliburton plug 240' to 230'
 20 sacks of cement 230' to 170'
 Mud 170' to 40'
 Rock bridge and Halliburton plug 40' to 30'
 10 sacks of cement 30' to 4'
 Surface soil 4' to Surface

Plugged and abandoned April 22, 1961.