

CARD MUST BE TYPED

State of Kansas

CARD MUST BE SIGNED

NOTICE OF INTENTION TO DRILL

-CORRECTED COPY-

-CORRECTED COPY- ✓

(see rules on reverse side)

SIGNATURE Starting Date 3-4-86 month day year

API Number 15-071-20,419-00-00 SIGNATURE 660' FSL W/2 SW SW/4 Sec. 14 Twp. 19 S, Rg. 43 East 660' Ft. from South Line of Section 4950' Ft. from East Line of Section

OPERATOR: License # 4868 Name Asher Associates, Inc. Address 5660 S. Syracuse Circle, #216 City/State/Zip Englewood, CO 80111 Contact Person Harold Patton Phone 303-770-4100

(Note: Locate well on Section Plat on reverse side) Nearest lease or unit boundary line 330 feet County Greeley Lease Name Pawax Well # 1

CONTRACTOR: License # 5422 Name Abercrombie Drilling, Inc. City/State Wichita, KS

Ground surface elevation feet MSL Domestic well within 330 feet: yes X no Municipal well within one mile: yes X no Depth to bottom of fresh water 260 Depth to bottom of usable water 1775 Surface pipe by Alternate 1 2 X Surface pipe planned to be set 500 Conductor pipe required None Projected Total Depth 5400 feet Formation Mississippian

Well Drilled For: Well Class: Type Equipment: X Oil SWD Infield X Mud Rotary Gas Inj Pool Ext Air Rotary OWWO Expl X Wildcat Cable

If OWWO: old well info as follows: Operator Well Name Comp Date Old Total Depth

I certify that well will comply with K.S.A. 55-101, et seq., plus eventually plugging hole to KCC specifications. Date Signature of Operator or Agent Harold Patton Title Pres. Asher Assoc., Inc.


For KCC Use: Conductor Pipe Required feet; Minimum Surface Pipe Required feet per Alt. 1 2 This Authorization Expires 8-3-86 Approved By 3-5-86

Must be filed with the K.C.C. five (5) days prior to commencing well
This card void if drilling not started within six (6) months of date received by K.C.C.

Important procedures to follow:

1. Notify District office before setting surface casing.
2. Set surface casing by circulating cement to the top.
3. File completion forms ACO-1 with K.C.C. within 90 days of well completion, following instructions on ACO-1, side 1, and including copies of wireline logs.
4. Notify District office 48 hours prior to old well workover or re-entry.
5. Prior to filing Intent, prepare a proposed plugging plan in case well is D & A, then obtain approval of plan when calling district office prior to setting surface pipe.
6. Submit plugging report (CP-4) to K.C.C. after plugging is completed.
7. Obtain an approved injection docket number before disposing of salt water.
8. Notify K.C.C. within 10 days when injection commences or terminates.

**A Regular Section of Land
1 Mile = 5,280 Ft.**

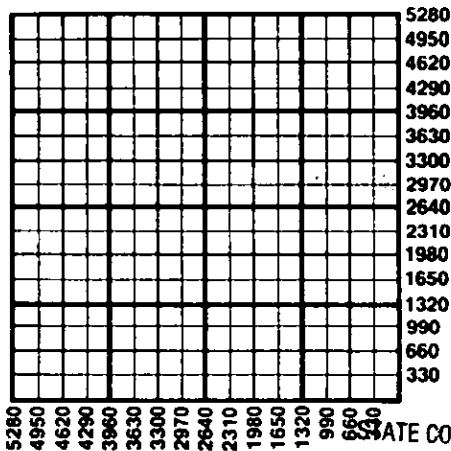

RECEIVED

MAR 11 1986
03-11-86
CONSERVATION DIVISION
Wichita, Kansas

If an alternate 2 completion, cement in the production pipe from below any usable water to surface within 120 days of spud date.

State Corporation Commission of Kansas
Conservation Division
200 Colorado Derby Building
Wichita, Kansas 67202
(316) 263-3238