


STATE OF KANSAS  
STATE CORPORATION COMMISSION

15169-20089-0000

WELL PLUGGING RECORD

Give All Information Completely  
Make Required Affidavit  
Mail or Deliver Report to  
Conservation Division  
State Corporation Comm.  
245 North Water  
Wichita, KS 67202

Saline County, Sec. 7 Twp. 16 Rge. 1W E/W  
Location as "NE/CNW $\frac{1}{4}$ SW $\frac{1}{4}$ " or footage from lines  
990' WEL & 330' NSL SW/4  
Lease Owner Dale Reese Oil Company  
Lease Name Odle Well No. 1  
Office Address 415 E. Prescott, Salina, Kansas 67401  
Character of Well (Completed as Oil, Gas or Dry Hole) Dry Hole

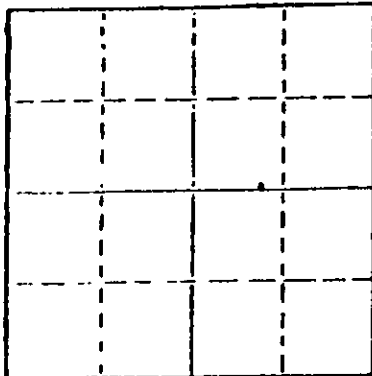

Locate well correctly on above Section Plot

Date Well completed October 7, 1978  
Application for plugging filed 19  
Application for plugging approved 19  
Plugging commenced 19  
Plugging completed October 7, 1978  
Reason for abandonment of well or producing formation Dry

If a producing well is abandoned, date of last production 19

Was permission obtained from the Conservation Division or its agents before plugging was commenced? Yes

Name of Conservation Agent who supervised plugging of this well Gilbert Toman  
Producing formation Depth to top Bottom Total Depth of Well  
Show depth and thickness of all water, oil and gas formations.

OIL, GAS OR WATER RECORDS

CASING RECORD

FORMATION	CONTENT	FROM	TO	SIZE	PUT IN	PULLED OUT
Shale & Shells		0	121'	8 5/8"	121'	None

Describe in detail the manner in which the well was plugged, indicating where the mud fluid was placed and the method or methods used in introducing it into the hold. If cement or other plugs were used, state the character of same and depth placed, from feet to feet for each plug set.

Set bottom plug at 120' with 15 sacks of cement. Filled with mud to 40' and set plug with 10 sacks of cement, 2 sacks in rathole. Job completed at 8:00 A. M., October 7, 1978. Plugging completed by State Plugger, Gilbert Toman, Holyrood, Kansas.

RECEIVED  
STATE CORPORATION COMMISSION

OCT 31 1978  
10-31-78

CONSERVATION DIVISION  
WICHITA, KANSAS

(If additional description is necessary, use BACK of this sheet)  
Name of Plugging Contractor Blackstone Drilling, Inc., Box 1184, McPherson, Kansas 67460


STATE OF Kansas COUNTY OF Saline, ss.  
Dale Reese Oil Company (employee of owner) or (owner or operator)  
of the above-described well, being first duly sworn on oath, says: That I have knowledge of the facts, statements, and matters herein contained and the log of the above-described well as filed and that the same are true and correct. So help me God.

DALE REESE OIL COMPANY  
(Signature) BY: Dale Reese  
415 E. Prescott, Salina, Kansas 67401  
(Address)

SUBSCRIBED AND SWORN TO before me this 30 day of October, 1978

Paul P. Younger  
Notary Public.

My commission expires Jan. 7, 1981

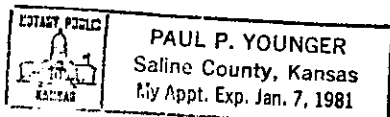

**Blackstone Drilling, Inc.**

15-169-20089-0000

Box 118A, 521 West Kansas • Phone (316) 241-1250  
McPHERSON, KANSAS 67460

October 10, 1978

COMPANY:

DALE REESE OIL COMPANY

CONTRACTOR:

BLACKSTONE DRILLING, INC.

FARM:

ODLE #1

LOCATION:

990' WEL & 330' NBL SW/4 Sec. 7-16-1W,  
Saline County, Kansas

COMMENCED:

October 2, 1978

COMPLETED:

October 7, 1978

ELEVATION:

0	to	121
121	to	800
800	to	1270
1270	to	2010
2010	to	2300
2300	to	2440
2440	to	2718
2718	to	2730
		2730

Shale & Shale  
Lime & Shale  
Shale & Lime  
Lime & Shale  
Shale & Lime  
Lime & Shale  
Lime  
Mississippi  
T. D.

RECEIVED  
STATE GEOLOGICAL SURVEY

OCT 3 1978

CONSERVATION DIVISION  
Wichita, Kansas

Cut 1 1/2" hole to 119' and run 1 1/2" of 8 5/8" surface pipe, cemented with 100 sacks of cement at 119'. Plug down at 11:45 A. M., October 2, 1978. Cut 7 7/8" hole to 2730'. Hole dry and abandoned. Set bottom plug at 120' with 15 sacks of cement. Filled with mud to 40'. Set top plug with 10 sacks of cement, 2 sacks in rathole. Plugging completed at 8:00 A. M., October 7, 1978. Plugging completed by State Plugger, Gilbert Tomlin, Holyrood, Kansas.

TOPS: LANSING - 2070'

MISSISSIPPI - 2718'

Measurements taken from L. R.

**CERTIFICATE**

I, Charles D. Johnson, Secretary-Treasurer of Blackstone Drilling, Inc. do hereby certify that the above and foregoing is a true and correct copy of log on your Odle #1, located SW/4 Section 7-16-1W, Saline County, Kansas as reflected by the files of Blackstone Drilling, Inc.

*[Signature]*  
Charles D. Johnson, Secretary-Treasurer  
Blackstone Drilling, Inc.

Subscribed and sworn to before me a Notary Public in and for McPherson County, Kansas this 10th day of October, 1978.

*[Signature]*  
Jehmie L. Schmitt-Notary Public