


WELL PLUGGING RECORD

Give All Information Completely  
Make Required Affidavit  
Mail or Deliver Report to:  
Conservation Division  
State Corporation Commission  
800 Bitting Building  
Wichita, Kansas

NORTH

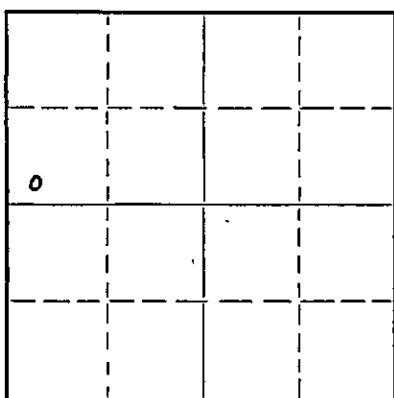

Locate well correctly on above Section Flat

Saline County. Sec. 9 Twp. 16S Rge. 1 (E) W (W)  
Location as "NE/CNW $\frac{1}{4}$ SW $\frac{1}{4}$ " or footage from lines SW SW NW  
Lease Owner DEEP ROCK OIL CORPORATION  
Lease Name Schweizerhof Well No. 1  
Office Address Box #1051, Tulsa, Oklahoma  
Character of Well (completed as Oil, Gas or Dry Hole) Dry  
Date well completed March 13 19 51  
Application for plugging filed March 13 19 51  
Application for plugging approved March 13 19 51  
Plugging commenced March 13 19 51  
Plugging completed March 13 19 51  
Reason for abandonment of well or producing formation Dry Hole

If a producing well is abandoned, date of last production 19  
Was permission obtained from the Conservation Division or its agents before plugging was commenced? Yes

Name of Conservation Agent who supervised plugging of this well Ruel Durkee  
Producing formation Mississippi Lime Depth to top 2680' Bottom 2745' Total Depth of Well 2945' Feet  
Show depth and thickness of all water, oil and gas formations.

OIL, GAS OR WATER RECORDS

CASING RECORD

Formation	Content	From	To	Size	Put In	Pulled Out
				10-3/4"	146'	None

Describe in detail the manner in which the well was plugged, indicating where the mud fluid was placed and the method or methods used in introducing it into the hole. If cement or other plugs were used, state the character of same and depth placed, from feet to feet for each plug set.

Filled hole with heavy mud from 2945' to 140'.  
Set rock bridge at 140'. Put in 20 sacks cement. Filled hole with mud and set rock bridge at 20'. Put in 5 sacks cement, filled hole to top and in bottom of cellar.

(If additional description is necessary, use BACK of this sheet)

Correspondence regarding this well should be addressed to Deep Rock Oil Corporation  
Address Box #529, Hutchinson, Kansas

STATE OF Kansas, COUNTY OF Reno, ss.  
Jack Smith (employee of owner) or (owner) of the above-described well,  
being first duly sworn on oath, says: That I have knowledge of the facts, statements, and matters herein contained and the log of the above-described well as filed and that the same are true and correct. So help me God.

(Signature) *Jack Smith*  
Box #129 Hutchinson Kansas (Address)

SUBSCRIBED AND SWORN to before me this 20<sup>th</sup> day of March 19 51  
*Barbara Williams* Notary Public.

My commission expires August 23, 1954 23-5091-s 8-50-10M

PLUGGING  
FILE SEC 9 T 16 R 1 W  
1051 BOX 67 LIME 14

3-23-51

Schweizerhof No. 1

15-169-00661-0000

SW, SW, NW,  
Section 9-16S-1W,  
Saline County, Kansas

Drilled for: Deep Rock Oil Corp.  
Drilled by: Beardmore Drilling Co., Inc.

Casing Record:

KEYS  
10-3/4" 146' w/100 ex

Drilling Commenced: March 1, 1951.  
Drilling Completed: March 13, 1951.

<u>FORMATION</u>	<u>DEPTH</u>
Cherty - shale	50
Shale clay	70
Shale - shells	146
Lime - shale	935
Shale - shells	1465
Shale - lime	1620
Shale - lime	1750
Lime	1890
Lime - shale	2000
Shale - lime	2061
Lime	2115
Lime broken	2150
Lime	2310
Shale - lime	2355
Lime - shale	2575
Shale - lime	2630
Lime	2745 T. D.

D & A

STATE OF KANSAS

COUNTY OF SEDGWICK

I, the undersigned, being duly sworn on oath, state that the above and within statement is a true and correct record and log of the well drilled on the location above-described, to the best of my knowledge and belief.

*[Handwritten Signature]*

Subscribed and sworn to before me this 17th day of March, 1951.

*Annette R. Kennalley*  
Notary Public

My commission expires:

Jan. 17, 1955.

**PLUGGING**  
FILE SEC 9 T 16 R 11  
PAGE 67 LINE 14

STATE OF KANSAS  
MAR 23 1951  
CONSERVATION DIVISION  
Wichita, Kansas