


Give All Information Completely  
Make Required Affidavit  
Mail or Deliver Report to:  
Conservation Division  
State Corporation Commission  
211 No. Broadway  
Wichita, Kansas

WELL PLUGGING RECORD

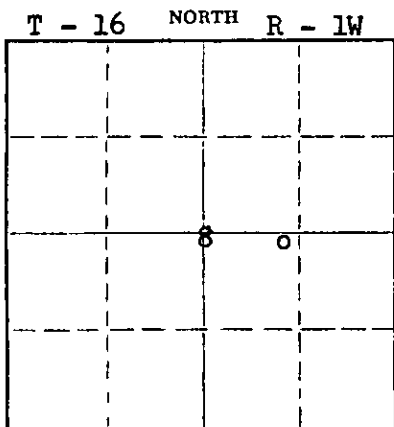

Locate well correctly on above Section Plat

Saline County. Sec. 8 Twp. 16 Rge. (E) 1 (W)  
Location as "NE/CNW&SW" or footage from lines NE-NW-SE  
Lease Owner Frank J. Black  
Lease Name Henne Well No. 1  
Office Address McPherson, Kansas  
Character of Well (completed as Oil, Gas or Dry Hole) Oil  
Date well completed 10-2 19 50  
Application for plugging filed 3-25 19 59  
Application for plugging approved 3-26 19 59  
Plugging commenced 3-30 19 59  
Plugging completed 4-4 19 59  
Reason for abandonment of well or producing formation Non-commercial

If a producing well is abandoned, date of last production 19  
Was permission obtained from the Conservation Division or its agents before plugging was commenced? Yes

Name of Conservation Agent who supervised plugging of this well Gilbert J. Toman  
Producing formation Depth to top Bottom Total Depth of Well 2708 Feet  
Show depth and thickness of all water, oil and gas formations.

OIL, GAS OR WATER RECORDS

CASING RECORD

FORMATION	CONTENT	FROM	TO	SIZE	PUT IN	PULLED OUT
				8 5/8	130	None
				5 1/2	2695	2429.25

Describe in detail the manner in which the well was plugged, indicating where the mud fluid was placed and the method or methods used in introducing it into the hole. If cement or other plugs were used, state the character of same and depth placed, from feet to feet for each plug set.

Sanded to 2690' - dumped 5 sks cement - mudded hole to 200' - set 10' rock bridge - bailed fluid down to rock bridge - dumped 25 sks cement - mudded to 40' - set 10' rock bridge - dumped 10 sks cement.

RECEIVED  
STATE CORPORATION COMMISSION  
APR 16 1959  
CONSERVATION DIVISION  
Wichita, Kansas

(If additional description is necessary, use BACK of this sheet)  
Name of Plugging Contractor R & D Casing Pulling Company License # 236  
Address Box 569 Ellinwood, Kansas

STATE OF KANSAS, COUNTY OF MCPHERSON, ss.  
Frank J. Black (owner or operator) of the above-described well, being first duly sworn on oath, says: That I have knowledge of the facts, statements, and matters herein contained and the log of the above-described well as filed and that the same are true and correct. So help me God.

(Signature) *Frank J. Black*

SUBSCRIBED AND SWORN TO before me this 14 day of April, 19 59

My commission expires Jan 10, 1961

(Address) *Wichita, Kansas*  
Notary Public.

PLUGGING  
FILE SEC. 8 T. 16 R. 1W  
BOOK PAGE 25 LINE 25

15-169-20156-0000


WELL LOC BUREAU : KANSAS GEOLOGICAL SOCIETY  
508 E. Hardeek, Wichita, Kansas

Company - P. S. WILLIAMS  
Farm - P. S. No. 1

SEC. 8 T. 16 R. 17  
NE 1/4 SE

Total Depth. 2708  
Comm. 9-17-50 Comp. 10-2-50  
Shot or Treated.  
Contractor. Hallard Drlg. Co.  
Issued. 10-28-50

County. Saline  
KANSAS

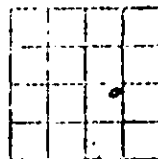

CASING:  
8 5/8" 130' com. w/90 sz.

Elevation. 1335F .....

Production. minimum well

Figures Indicate Bottom of Formations.

surface sand	130
shale & shells	170
shale, anhyd.	360
shale & lime sdy	580
lime sdy	775
lime & shale	1135
shale & shells	1440
lime & shale	2205
lime	2320
lime & shale RTD	2698
chat, show of oil & water	2708

Total Depth

Tops:  
Chat 2695

Acidized w/2000 gals. w/wtr.

Measurements taken from derrick floor.

Comp. 15 COPD

**RECEIVED**  
STATE GEOLOGICAL COMMISSION  
APR 16 1959  
CONSERVATION DIVISION  
Wichita, Kansas

**PLUGGING**  
FILE SEC. 8 T. 16 R. 17  
BOOK PAGE 25 LINE 25