

OR
FORMATION PLUGGING RECORD

Strike out upper line when reporting plugging of formations.

Give All Information Completely
Make Required Affidavit
Mail or Deliver Report to:
Conservation Division
State Corporation Commission
800 Bittling Building
Wichita, Kansas

Saline

County. Sec. 8 Twp 16S Rge. (E) 1 (W)

Location as "NE $\frac{1}{4}$ NW $\frac{1}{4}$ SW $\frac{1}{4}$ " or footage from lines NE $\frac{1}{4}$ NW $\frac{1}{4}$ NW $\frac{1}{4}$

Lease Owner E.S. Adkins

Lease Name Andrew Well No. 1

Office Address 912 Philtower Bldg., Tulsa, Oklahoma.

Character of Well (completed as Oil, Gas or Dry Hole) Dry

Date well completed November 25, 19 42

Application for plugging filed November 25, 19 42

Application for plugging approved November 25, 19 42


Plugging commenced November 25, 19 42

Plugging completed November 25, 19 42

Reason for abandonment of well or producing formation
No oil or gas

If a producing well is abandoned, date of last production None 19

Was permission obtained from the Conservation Division or its agents before plugging was commenced? Yes

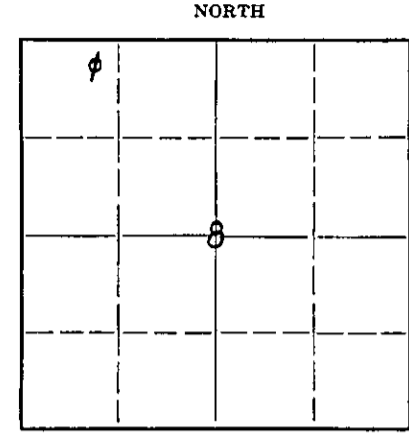

Locate well correctly on above Section Plat

Name of Conservation Agent who supervised plugging of this well

Producing formation Depth to top Bottom Total Depth of Well 2719 Feet

Show depth and thickness of all water, oil and gas formations.


OIL, GAS OR WATER RECORDS

CASING RECORD

Formation	Content	From	To	Size	Put In	Pulled Out

Describe in detail the manner in which the well was plugged, indicating where the mud fluid was placed and the method or methods used in introducing it into the hold. If cement or other plugs were used, state the character of same and depth placed, from feet to feet for each plug set.

Filled with heavy rotary mud from 2719' to 110'
 Filled with cement from 110' to 85'
 Filled with heavy rotary mud from 85' to 4'
 Cut off 8-3/4" surface casing 4' down from top of surface
 Welded plate over surface casing, dumped 5 sacks of cement in bottom of cellar on top of 8-3/4" surface casing.

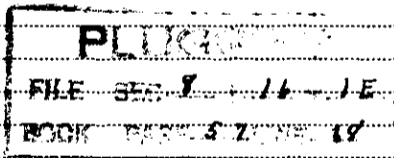

(If additional description is necessary, use BACK of this sheet)

Correspondence regarding this well should be addressed to E.S. Adkins
 Address 912 Philtower Building, Tulsa, Oklahoma.

STATE OF Oklahoma, COUNTY OF Tulsa, ss.

(employee of owner) or (owner or operator) of the above-described well, being first duly sworn on oath, says: That I have knowledge of the facts, statements, and matters herein contained and the log of the above-described well as filed and that the same are true and correct. So help me God.

(Signature) X *E.S. Adkins*

(Address) 12-16-42

SUBSCRIBED AND SWORN TO before me this 15th day of December, 1942

Sara S. Mulford
Notary Public.

My commission expires July 11, 1946

December 9, 1942

Well No. 1
 Farm: Andrew
 Location: Sec. 8-16S-1W., Saline County, Kansas
 Rigging Up: November 11, 1942
 Completed: November 27, 1942
 Bits: 7 - 7 7/8"
 Company: E.S. Adkins Oil Company
 Drilling Contractor: Creekmore Drilling Company

Casing Record:

SIZE	FEET	REMARKS
8-5/8"	100	Cemented/w 75 sacks cem.

FORMATION:

Sand Rock	0	103
Broken Lime and Shale	103	600
Broken Lime	600	675
Shale and Lime Shells	675	725
Lime	725	735
Broken Lime	735	890
Shale	890	1550
Broken Lime	1550	1715
Lime	1715	1865
Shale	1865	2049
Lime	2049	2440
Shale	2440	2672
Lime	2672	2702
Dolomite	2702	2704
Cored	2704	2719 T.D.

PLUGGING
 FILE SEC. 8-T 16-R 1E
 BOOK PAGE 57 LINE 12