


STATE OF KANSAS
STATE CORPORATION COMMISSION

Give All Information Completely
Make Required Affidavit
Mail or Deliver Report to:
Conservation Division
State Corporation Commission
211 N. Broadway
Wichita, Kansas

15-169-19131-0000
WELL PLUGGING RECORD

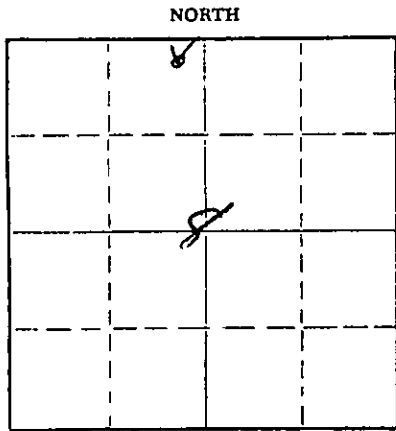

Locate well correctly on above Section Plat

Saline County. Sec. 8 Twp. 16 Rge. (E) 1 (W)

Location as "NE/CNWxSWx" or footage from lines NE NE NW
Lease Owner F. S. Williams
Lease Name Andrews Well No. 1
Office Address Box 746, McPherson, Kansas
Character of Well (completed as Oil, Gas or Dry Hole) Oil
Date well completed Feb 10 1950
Application for plugging filed 4-27-62 corrected app filed 7-5-62
Application for plugging approved Feb 10 4-28-62
Plugging commenced 6-27
Plugging completed 7-2
Reason for abandonment of well or producing formation Non-Commercial
If a producing well is abandoned, date of last production 19
Was permission obtained from the Conservation Division or its agents before plugging was commenced? yes

Name of Conservation Agent who supervised plugging of this well Gilbert Toman
Producing formation _____ Depth to top _____ Bottom _____ Total Depth of Well 2681 Feet
Show depth and thickness of all water, oil and gas formations.

OIL, GAS OR WATER RECORDS

CASING RECORD

FORMATION	CONTENT	FROM	TO	SIZE	PUT IN	PULLED OUT
<u>Chert</u>	<u>oil</u>	<u>2667</u>	<u>81</u>	<u>8 5/8"</u>	<u>125'</u>	<u>none</u>
				<u>5 1/2"</u>	<u>2645'</u>	<u>2403'</u>

Describe in detail the manner in which the well was plugged, indicating where the mud fluid was placed and the method or methods used in introducing it into the hole. If cement or other plugs were used, state the character of same and depth placed, from _____ feet to _____ feet for each plug set.

Sanded hole to 2635'-dumped 5 sks cement-
pulled casing-mudded hole to 165'-set 15'
rock bridge-dumped 25 sks cement-mudded to
35'-set 5' rock bridge-dumped 10 sks cement.

RECEIVED
STATE CORPORATION COMMISSION
JUL 9 1962
CONSERVATION DIVISION
Wichita, Kansas

(If additional description is necessary, use BACK of this sheet)
Name of Plugging Contractor R & D Casing Pulling Co. License #236
Address Box 572, Hutchinson, Kansas

STATE OF Kansas COUNTY OF McPherson, ss.
F. S. Williams (employee of owner) or (owner or operator) of the above-described well, being first duly sworn on oath, says: That I have knowledge of the facts, statements, and matters herein contained and the log of the above-described well as filed and that the same are true and correct. So help me God.

(Signature) F. S. Williams
McPherson, Ks.
(Address)

SUBSCRIBED AND SWORN TO before me this 6th day of July, 1962.

My commission expires 9-11-1962 Notary Public.

COPY

WELL LOG BUREAU KANSAS GEOLOGICAL SOCIETY
308 East Murdock Wichita, Kansas

15-169-19131-0000


Company - DAN J. KORNFELD - F. S. WILLIAMS
Farm - Andrews No. 1

SEC. 8 T. 16 R. 1W
NE NE NW

Total Depth. 2682
Comm. 1-27-50 Comp. 2-2-50

County. Saline
KANSAS

Shot or Treated.
Contractor. Mallard Drilling Company
Issued. 3-4-50

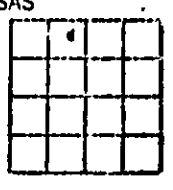

CASING:

8 5/8" 125' Com. w/90 sx
5 1/2" 2665' Com. w/45 sx

Elevation. _____

Production. Phy. Pot. 50 BO

Figures Indicate Bottom of Formations.

shale & lime	125
anhy. & shalo	230
shalo - anhy.	410
shalo & sandy lime	585
sandy limo & shalo	715
sandy limo & shalo	900
shalo & shells	1310
shalo & lime	1595
shalo & lime	1745
shalo & lime	1955
limo & shalo	2075
lime	2185
lime & Shalo	2643
lime AT D. rotary	2666
hard chert-some dolo.	2667
chert - some shalo	2668 1/2
soft dolomite	2670 1/2
hard white dolomite	2671
hard white dolomite	2673
hard white dolomite	2676 1/2
dolomite - S.O.	2679 1/2
dolomite - S.O.	2681
dolomite	2682
Total Depth	

Tops:
Mississippi 2665

Acidized through casing with 2000 gals.
1 1/2 barrels oil per hour. Measurements
taken from derrick floor.

RECEIVED
STATE CORPORATION COMMISSION
JAN 8 1969
CONSERVATION DIVISION
Wichita, Kansas

COMPANY: Dan J. Kornfeld--F. S. Williams
 CONTRACTOR: Mallard Drilling Company
 FARM: Andrews #1
 LOCATION: NE NE NW Sec. 8-16-1
 Saline County, Kansas
 COMMENCED: January 27, 1950 --rotary
 COMPLETED: February 2, 1950--rotary

0	to	125	Shale and lime
125		230	Anhydrite-shale
230		410	Shale-anhydrite
410		585	Shale and sandy lime
585		715	Sandy lime and shale
715		900	Sandy lime and shale
900		1310	Shale and shells
1310		1595	Shale and lime
1595		1745	Shale and lime
1745		1955	Shale and lime
1955		2075	Lime and shale
2075		2185	Lime
2185		2285	Lime and shale
2285		2355	Lime and shale
2355		2560	Lime and shale
2560		2643	Shale and lime
2643		2666	Lime--T.D. rotary
2666		2667	Hard Chert-some dolomite
2667		2668 $\frac{1}{2}$	Chert-some shale
2668 $\frac{1}{2}$		2670 $\frac{1}{2}$	Soft Dolomite
2670 $\frac{1}{2}$		2671	Hard white dolomite
2671		2673	Hard white dolomite
2673		2676 $\frac{1}{2}$	Hard white dolomite
2676 $\frac{1}{2}$		2679 $\frac{1}{2}$	Dolomite--show of oil
2679 $\frac{1}{2}$		2681	Dolomite--shew of oil
2681		2682	Dolomite
		2682	T.D.

Set 125 feet of 8 5/8" surface pipe. Cemented with 90 sacks cement.

Set 5 $\frac{1}{2}$ " pipe at 2665. Cemented with 45 sacks cement.

TOPS: Mississippi--2665

Acidized through casing with 2000 gallons.

1 $\frac{1}{2}$ barrels oil per hour

Measurements taken from derrick floor

C E R T I F I C A T E

I, Max Wright, do hereby certify that the above and foregoing is a true and correct copy of log of the Andrews #1, Sec. 8-16-1, Saline County, Kansas, as reflected by files of the Mallard Drilling Company.

Max Wright

Subscribed and sworn to before me a Notary Public, within and for Sedgwick County, Kansas, this 23rd day of February 1950.

Marcella H. Davis

MY commission expires Feb 27-1952