


Give All Information Completely  
Make Required Affidavit  
Mail or Deliver Report to:  
Conservation Division  
State Corporation Commission  
211 No. Broadway  
Wichita, Kansas

WELL PLUGGING RECORD

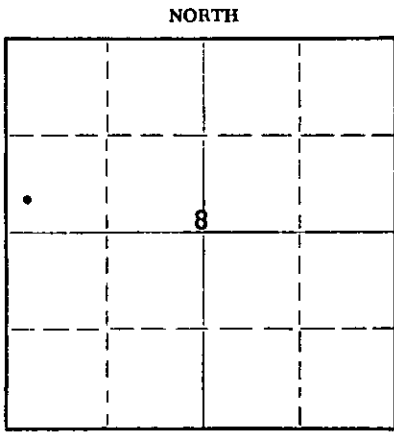

Locate well correctly on above Section Plat

Saline County. Sec. 8 Twp. 16 Rge. 1 (E) W (W)  
Location as "NE/CNW/SW" or footage from lines SW NW  
Lease Owner F. S. Williams  
Lease Name Johnson "B" Well No. 4  
Office Address 202 Maltby Bldg., McPherson Kansas  
Character of Well (completed as Oil, Gas or Dry Hole) ~~Oil~~ Well Dry Hole  
Date well completed X April 30 4/30 1957  
Application for plugging filed X May 20 1957  
Application for plugging approved V May 23 1957  
Plugging commenced May 22 1957  
Plugging completed May 25 1957  
Reason for abandonment of well or producing formation Non-Commercial

If a producing well is abandoned, date of last production X Dry 19  
Was permission obtained from the Conservation Division or its agents before plugging was commenced? Yes

Name of Conservation Agent who supervised plugging of this well Ruel Durkee  
Producing formation Mississippi Depth to top 2674' Bottom 2701 1/2' Total Depth of Well 2701 1/2' Feet  
Show depth and thickness of all water, oil and gas formations.

OIL, GAS OR WATER RECORDS

CASING RECORD

FORMATION	CONTENT	FROM	TO	SIZE	PUT IN	PULLED OUT
Burgess SU	3 BOPD	2658	2679	8 5/8"	135'	None
Chert	Dry	2679	2701 1/2'	5 1/2"	2674'	2402'

Describe in detail the manner in which the well was plugged, indicating where the mud fluid was placed and the method or methods used in introducing it into the hole. If cement or other plugs were used, state the character of same and depth placed, from \_\_\_\_\_ feet to \_\_\_\_\_ feet for each plug set.

Plugged bottom of hole from 2701 1/2' to 2655' with sand  
Dumped 6 sx. cement at 2655'  
Shot 5 1/2" casing loose at 2402' and pulled same.  
Mudded hole  
Built rock bridge at 130' and dumped 15 sx. cement on same.  
Mudded hole to 20' of surface.  
Dumped 5 sx. cement plug from 20' to bottom of cellar. Job Completed.

(If additional description is necessary, use BACK of this sheet)  
Name of Plugging Contractor Wiggins & Lamb Pipe Pulling Co.  
Address P.O. Box 191, McPherson Kansas

STATE OF Kansas, COUNTY OF McPherson, ss.  
F. S. Williams (employee of owner) or (owner or operator) of the above-described well, being first duly sworn on oath, says: That I have knowledge of the facts, statements, and matters herein contained and the log of the above-described well as filed and that the same are true and correct. So help me God.

(Signature) F. S. Williams  
Box 746 McPherson Kansas  
(Address)

SUBSCRIBED AND SWORN TO before me this 31st day of MAY, 1957

My commission expires 9-14-1958

Roger Notary Public  
STATE CORPORATION COMMISSION

PLUGGING  
FILE SEC. 8 T. 16 W. 1W  
BOOK PAGE 14 LI 39

JUN 10 1957  
CONSERVATION DIVISION  
WICHITA, KANSAS

WELL LOG

15-169.00660.0000

TASS WILLIAMS, etal  
 Company: ~~GREENLAND DRILLING COMPANY~~

Sec. 8 Twp. 16S Rge. 1W  
 Location: SW SW NW  
 Saline County, Kansas

Farm: JOHNSON "B" No. 4

Commenced: 4-9-57  
 Completed: 4-15-57  
 Total Depth: 2664  
 Contractor: GREENLAND DRILLING COMPANY

Casing: 8-5/8" 132'  
 5-1/2" 2658'

Elevation:  
 Production:

## Figures Indicate Bottom of Formations

		TOPS:
90	Clay & shale	
132	Shale & lime	
175	Lime and shale	
315	Lime w/shale streaks	
520	Lime	
690	Lime & shale	
1895	Shale & lime	
2088	Lime & shale	
2188	Lime w/shale breaks	
2275	Shale & lime	
2391	Lime & shale	
2664	Shale & lime	

## Cable Tools.

2659 5" casing cemented  
 2659-2684 Sand-(Burgess)  
 2659-2664 3 BOPD  
 2659-2669 Frac Hole full of water  
 2684-2704½ Mississippi Dolomite  
 2700½-2704½ Slight stain  
 Acidze 1000 gals. Hole full water.

Dry and abandoned.

STATE OF KANSAS, COUNTY OF SEDGWICK, ss:

I, Oscar Bridge, Vice-President of Greenland Drilling Company, upon oath state that the above and foregoing is a true and correct copy of the log of the #4 Johnson "B" well.

Oscar Bridge  
 Oscar Bridge, Vice-President

Subscribed and sworn to before me this 30th day of April, 1957.

My commission expires March 15, 1960.

Verdina B. Rutledge  
 Verdina B. Rutledge, Notary Public