


WELL PLUGGING RECORD

Give All Information Completely
Make Required Affidavit
Mail or Deliver Report to:
Conservation Division
State Corporation Commission
800 Biting Building
Wichita, Kansas

NORTH

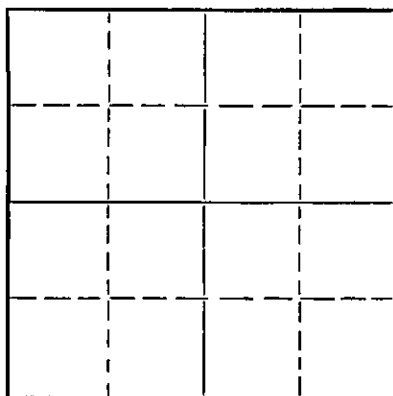

Locate well correctly on above
Section Plat

Saline

County, Sec. 8 Twp. 16 Rge. (E) 1(W)
Location as "NE/CNW/SE" or footage from lines S 2 1/2 N 1/2 NE
Lease Owner ~~Swisher~~ F.S. Williams
Lease Name Swisher Well No. 3
Office Address Box 746, McPherson, Kansas.
Character of Well (completed as Oil, Gas or Dry Hole) Dry Hole
Date well completed July 3rd, 1951
Application for plugging filed June 1951
Application for plugging approved June 1951
Plugging commenced June 26th 1951
Plugging completed July 3rd, 1951
Reason for abandonment of well or producing formation Dry Hole

If a producing well is abandoned, date of last production 19...
Was permission obtained from the Conservation Division or its agents before plugging was commenced? yes

Name of Conservation Agent who supervised plugging of this well Ruel Durkee
Producing formation Depth to top Bottom Total Depth of Well 2687 Feet
Show depth and thickness of all water, oil and gas formations.

OIL, GAS OR WATER RECORDS

CASING RECORD

Formation	Content	From	To	Size	Put In	Pulled Out
Surface		0	150	8 5/8	150	0
Mississippi Ls.		0	2687'	5 1/2	2687	2464

Describe in detail the manner in which the well was plugged, indicating where the mud fluid was placed and the method or methods used in introducing it into the hole. If cement or other plugs were used, state the character of same and depth placed, from feet to feet for each plug set.

Filled hole back to bottom of 5" Dumped 6 sacks cement. Shot pipe off at 2464'. Pulled pipe and mudded hole to 150' set rock bridge and finished mudding hole and put 5 sacks cement at top of surface.

Plugged by Bert Self, Casing Puller, Hutchinson, Kansas.

(If additional description is necessary, use BACK of this sheet)

Correspondence regarding this well should be addressed to F.S. Williams
Address Box 746, McPherson, Kansas.

STATE OF _____, COUNTY OF _____, SS.

(employee of owner) or (owner or operator) of the above-described well, being first duly sworn on oath, says: That I have knowledge of the facts, statements, and matters herein contained and the log of the above-described well as filed and that the same are true and correct. So help me God.

(Signature) F.S. Williams


By Dan J. Kornfeld, (Address)

SUBSCRIBED AND SWORN to before me this 8th day of August, 1951

My Commission Expires Jan. 31, 1953

My commission expires

Notary Public.

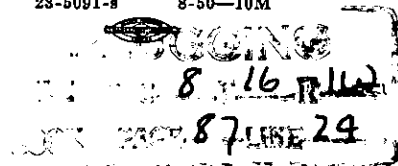

F. S. WILLIAMS

MCPHERSON, KANSAS

15-169-00709-0000

Date _____

Lease _____ Joint Operating Statement for the Month of _____

Statement No. _____

Swisher # 3
 C-S line N $\frac{1}{2}$ NE $\frac{1}{4}$
 8-16-1W
 Saline County, Kansas
 Elevation 1303 HL

Rotary Total Depth	2674
Top of Chat	2671
5' cemented	2672

Cable Tools

Total depth from derrick floor	2670
Dolomite white, no trace of oil	2670
Dolomite white, very slight stain	72
Dolomite gray, very slight stain	74 $\frac{1}{2}$
Lime gray, no show	77 $\frac{1}{2}$
Lime gray and dolomite stained, small sho of oil, chert white	80 $\frac{1}{2}$
Lime gray and dolomite	82 $\frac{1}{2}$

5-29-51

Well set 16 hours 110' of fluid of which there was about $\frac{1}{2}$ bailer oil. Water salty - well making water.

2682 $\frac{1}{2}$

Dolomite gray, porous, slight stain, small sho
oil

84 $\frac{1}{2}$

Dolomite fine - some saturation inc. oil

86

1 hour test 10 gals. oil 20 gals. water

2 hour test 20 gals. oil 40 gals. water

Preparing to plug back with Lead Wool, (about 1')

5-30-51

Fluid in hole

485'

Drove 100# lead wool, plug back 1' TD

2865

Swabbed and bailed hole dry

Let set one hour

1 hour test 10 gals. oil 10 gals. water

Acidized 2000 gals.

RECORDED
 STATE COMMISSION
 JUN 12 1951
 CONSERVATION DIVISION
 Wichita, Kansas

F. S. WILLIAMS

MCPHERSON, KANSAS

15-169-00709-0000

Date _____

Lease _____ Joint Operating Statement for the Month of _____

Statement No. _____

5-31-51

550' fluid over nite (16 hours)
Swab all water, no oil (acid-water)
Drilling on lead wool and bailing hole
1 hour test 6 gald. oil 50 gals water

At this point it was either a question of strato-lift or acid pilot job.

After careful consideration Mr. Kornfeld and I decided our chances of making a well were zero.

Well dry and abandoned.

COMPANY: F. S. WILLIAMS
 CONTRACTOR: Mallard Drilling Company
 FARM: Swisher #3
 LOCATION: S/2 N/2 NE/4 Sec. 8-16-1W
 Saline County, Kansas
 COMMENCED: May 3, 1951--rotary
 May 26, 1951--cardwell
 COMPLETED: May 13, 1951--rotary
 June 3, 1951--cardwell

0	to	110	Sand and shale
110	to	190	Lime and shale
190	to	365	Lime
365	to	640	Lime
640	to	825	Lime and sand
825	to	1300	Shale and shells
1300	to	1635	Shale and lime
1635	to	1780	Shale and lime
1780	to	1910	Lime
1910	to	2085	Shale and lime
2085	to	2330	Lime
2330	to	2630	Lime and shale
2630	to	267	Chat
		2672	T. D. Rotary
2672	to	2687	Chat
2687	to	2687 1/2	Dolomite, show of well
2687 1/2	to	2687	Chat, show of water
		2687	T. D. Cardwell

Set 110' of 8 5/8" surface pipe. Cemented with 90 sacks cement.
 Set 5 1/2" pipe at 2670. Cemented with 40 sacks cement.

TOPS: Mississippi--2669
 Measurements taken from derrick floor
 Acidized with 2000 gallons of water. No good.

DRY

C E R T I F I C A T E

I, C. C. Nelson, do hereby certify that the above and foregoing is a true and correct copy of log of the Swisher #3, Sec. 8-16-1W, Saline County, Kansas as reflected by filed of the Mallard Drilling Company.

C. C. Nelson

My commission expires

Subscribed and sworn to before me a Notary Public, within and for Sedgwick County, Kansas, this 6th day of June 1951.

Raymond Wright

My commission expires

PLUGGING
 FILE SEC 8-T-16R-1W
 BOOK PAGE 87 LINE 24