


Give All Information Completely  
Make Required Affidavit  
Mail or Deliver Report to:  
Conservation Division  
State Corporation Commission  
800 Bitting Building  
Wichita, Kansas

15-169-00521-0000

WELL PLUGGING RECORD

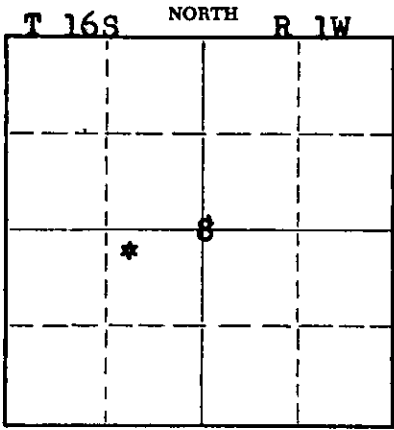

Locate well correctly on above Section Plat

Saline County. Sec. 8 Twp. 16S Rge. 1W (E) (W)  
Location as "NE/CNW/SW" or footage from lines NW NE SW  
Lease Owner F. S. Williams  
Lease Name Johnson "B" Well No. 2  
Office Address 202 Malthy Bldg. - McPherson, Kansas  
Character of Well (completed as Oil, Gas or Dry Hole)  
Date well completed October 2 19 52  
Application for plugging filed Feb 1 19 56  
Application for plugging approved Feb 10 19 56  
Plugging commenced February 27 19 56  
Plugging completed March 6 19 56  
Reason for abandonment of well or producing formation

If a producing well is abandoned, date of last production 19  
Was permission obtained from the Conservation Division or its agents before plugging was commenced? Yes

Name of Conservation Agent who supervised plugging of this well Ruel Durkee  
Producing formation Depth to top Bottom Total Depth of Well 2693' Feet  
Show depth and thickness of all water, oil and gas formations.

OIL, GAS OR WATER RECORDS				CASING RECORD		
FORMATION	CONTENT	FROM	TO	SIZE	PUT IN	PULLED OUT
Chat	2687-93 1/2	12.00 PD	2690-93 1/2	8-5/8"	127'	None
				5-1/2"	2687'	2166'
Sand frac	Apr 1954	Poor	Results.			

Describe in detail the manner in which the well was plugged, indicating where the mud fluid was placed and the method or methods used in introducing it into the hole. If cement or other plugs were used, state the character of same and depth placed, from feet to feet for each plug set.

Filled the hole with sand from 2693' to 2675' and ran 6 sacks of cement. Mudded the hole to 130', set a 10' rock bridge and ran 15 sacks of cement. Mudded the hole to 15' and ran 5 sacks of cement on top. Plugging completed.

(If additional description is necessary, use BACK of this sheet)  
Name of Plugging Contractor West Supply Co., Inc.  
Address Chase, Kansas

STATE OF March 15 56, COUNTY OF McPherson, ss.  
F. S. Williams (employee of owner) or (owner or operator) of the above-described well, being first duly sworn on oath, says: That I have knowledge of the facts, statements, and matters herein contained and the log of the above-described well as filed and that the same are true and correct. So help me God.

(Signature) F. S. Williams  
Box 746 McPherson, Kansas (Address)

SUBSCRIBED AND SWORN TO before me this 15 day of March, 19 56  
Notary Public.

My commission expires 9-14-1958

**PLUGGING**  
FILE SEC 8 T 16 R 1W  
BOOK PAGE 37 LINE 44

3-16-56  
Wichita, Kansas

15169005210000

COMPANY: F. S. Williams  
 CONTRACTOR: Mallard Drilling Company  
 FARM: Johnson B 2  
 LOCATION: NW NE SW Sec. 8-16-1W  
 Saline County, Kansas  
 COMMENCED: October 2, 1952--retary  
 COMPLETED: October 11, 1952--retary

0	to	60	Shale and sand
60	to	127	Shale
127	to	170	Lime
170	to	345	Lime
345	to	600	Lime
600	to	745	Lime
745	to	935	Sand and lime
935	to	1390	Shale and lime
1390	to	1660	Shale and lime
1660	to	1770	Shale and lime
1770	to	1855	Lime
1855	to	1960	Lime and shale
1960	to	2040	Lime and shale
2040	to	2060	Lime and shale
2060	to	2210	Lime
2210	to	2445	Lime
2445	to	2685	Lime and shale
2685	to	2687	Chat--T.D. Retary
2687	to	2693 $\frac{1}{2}$	Chat and dolomite--oil stain
		2693 $\frac{1}{2}$	T.D. Cardwell

Set 127 feet of 8 5/8" surface pipe. Cemented with 90 sacks cement.

Set 5 1/2" at 2687. Cemented with 40 sacks cement.

TOPS: Mississippi--2681

Acidized with 1000 gallons.

Measurements taken from derrick floor

Minimum Well

C E R T I F I C A T E

**PLUGGING**  
 FILE SEC. 8-16-R-14  
 BOOK PAGE 27 LINE 44

I, C. C. Nelson, do hereby certify that the above and foregoing is a true and correct copy of log of the Johnson B 2, Sec. 8-16-1W, Saline County, Kansas, as reflected by files of the Mallard Drilling Company.

C. C. Nelson

Subscribed and sworn to before me a Notary Public, within and for Sedgwick County, Kansas, this 21 day of October 1952.

Marcella A. Davis

My commission expires Feb 27-1956