

STATE OF KANSAS
STATE CORPORATION COMMISSION

Form CP-4


Give All Information Completely
Make Required Affidavit
Mail or Deliver Report to:
Conservation Division
State Corporation Commission
212 No. Market
Wichita, Kansas

WELL PLUGGING RECORD

Saline County. Sec. 8 Twp. 16 Rge. 1 ~~XX~~ (W)

Location as "NE/CNW&SW&" or footage from lines NE/4 SE/4 SW/4
Lease Owner Cal Jones
Lease Name Henne Well No. 1
Office Address Canton, Kansas 67428
Character of Well (completed as Oil, Gas or Dry Hole) Dry Hole
Date well completed October 28 19 69
Application for plugging filed _____ 19____
Application for plugging approved _____ 19____
Plugging commenced _____ 19____
Plugging completed October 28, 19 69
Reason for abandonment of well or producing formation Dry Hole

NORTH

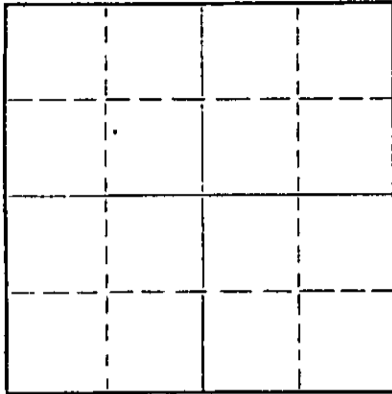

Locate well correctly on above Section Plat

If a producing well is abandoned, date of last production _____ 19____
Was permission obtained from the Conservation Division or its agents before plugging was commenced? Yes

Name of Conservation Agent who supervised plugging of this well Gilbert Toman
Producing formation _____ Depth to top _____ Bottom _____ Total Depth of Well _____ Feet
Show depth and thickness of all water, oil and gas formations.

OIL, GAS OR WATER RECORDS

CASING RECORD

FORMATION	CONTENT	FROM	TO	SIZE	PUT IN	PULLED OUT
Shale		0	105'	8 5/8"	105'	None
Lime & Shale		105'	336'	8 5/8"	425'	None

Describe in detail the manner in which the well was plugged, indicating where the mud fluid was placed and the method or methods used in introducing it into the hole. If cement or other plugs were used, state the character of same and depth placed, from _____ feet to _____ feet for each plug set.

Set first plug at 120 ft., put in 25 sacks cement.
Filled with mud to 410', set plug and put in 10 sacks cement. 2 sacks in rathole. Plug down at 12:00 A. M., October 28, 1969. Plugging completed by State Plugger, Gilbert Toman, Holyrood, Kansas.

RECEIVED
STATE CORPORATION COMMISSION
NOV 5 - 5 1969
CONSERVATION DIVISION
Wichita, Kansas

(If additional description is necessary, use BACK of this sheet)


Name of Plugging Contractor Blackstone Drilling, Inc.
Address Box 455, McPherson, Kansas - 67460

STATE OF Kansas, COUNTY OF McPherson, ss.
Cal Jones (employee of owner) or (owner or operator) of the above-described well, being first duly sworn on oath, says: That I have knowledge of the facts, statements, and matters herein contained and the log of the above-described well as filed and that the same are true and correct. So help me God.

(Signature) Cal Jones
Canton, Kansas - 67428
(Address)

SUBSCRIBED AND SWORN TO before me this 31st day of October, 19 69

My commission expires August 11, 1973
Jack C. Jones Jr. Notary Public.

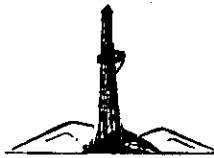

Blackstone Drilling, Inc.

Box 455 • 523 West Kansas • Phone CH 1-1250

McPHERSON • KANSAS

67460
October 29, 1969

15-169-20026-0000

COMPANY: CAL JONES
 CONTRACTOR: BLACKSTONE DRILLING, INC.
 FARM: WENNE #1
 LOCATION: NE/4 SE/4 SW/4 Sec. 8-16-1W,
 Saline County, Kansas
 COMMENCED: October 28, 1969
 COMPLETED: October 28, 1969
 ELEVATION: 1320 K. B.

0	to	105	Shale
105	to	530	Lime & Shale
530	to	745	Lime
745	to	1065	Lime & Shale
1065	to	1445	Shale & Lime
1445	to	1705	Lime
1705	to	2028	Lime & Shale
2028	to	2079	Lansing Lime
2079	to	2375	Lime
2375	to	2509	Lime & Shale
2509	to	2620	Shale & Lime
2620	to	2683	Lime & Shale
2683	to	2692	Burgess Sand
2692	to	2710	Mississippi
		2710	T. D.

RECEIVED
 STATE CORPORATE COMMISSION
 DEC 23 1969
 CONSERVATION DIVISION
 Wichita, Kansas

Cut 12 1/4 in. hole to 125.5 ft. and run 125.5 ft. of 2 5/8 in. surface pipe, cemented with 85 sacks at 128 ft., plug down at 2:30 P. M., October 23, 1969. Cut 7 7/8 in. hole to 2710 ft. Hole dry and abandoned. Set bottom plug at 120 ft. with 25 sacks of cement. Filled with mud to 40 ft., set plug and put in 10 sacks of cement and 2 sacks in rat hole. Hole plugging completed at 12:00 A. M., October 28, 1969 by Gilbert Toman, State Plugger of Holyrood, Kansas.

TOPS: Kansas City - 2028' Burgess Sand - 2683' Mississippi - 2692'

Measurements taken from K. B.

CERTIFICATE

I, H. J. Plouffe, President of Blackstone Drilling, Inc. do hereby certify that the above and foregoing is true and correct copy of log on your Wenne #1, located on the NE/4 SE/4 SW/4 Sec. 8-16-1W, Saline County, Kansas as reflected by the files of Blackstone Drilling, Inc.

H. J. Plouffe, President

Subscribed and sworn to before me a Notary Public in and for McPherson County, Kansas this 29 day of October, 1969.

Johnnie L. Schmidt, Notary Public

