


15-071-20031-00-00

STATE OF KANSAS
STATE CORPORATION COMMISSION

Give All Information Completely
Make Required Affidavit
Mail or Deliver Report to:
Conservation Division
State Corporation Commission
P. O. Box 17027
Wichita, Kansas 67217

WELL PLUGGING RECORD

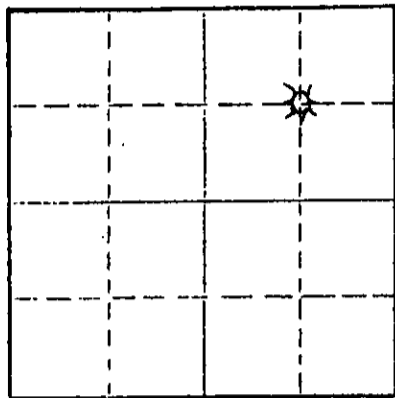

Locate well correctly on above
Section Plat

Greeley County, Sec. 31 Twp. 19 Rge. 40 (W)
Location as "NE/CNW&SW" or footage from lines C NE/4
Lease Owner Dorchester Exploration Incorporated
Lease Name Wear "A" Well No. 1
Office Address 1204 Vaughn Bldg; Midland, Texas 79701
Character of Well (completed as Oil, Gas or Dry Hole) Dry hole
Date well completed October 14, 1973 19
Application for plugging filed July 21, 1974 19
Application for plugging approved July 23, 1974 19
Plugging commenced August 16, 1974 19
Plugging completed August 17, 1974 19
Reason for abandonment of well or producing formation non-commercial

If a producing well is abandoned, date of last production none 19
Was permission obtained from the Conservation Division or its agents before plugging was commenced? Yes

Name of Conservation Agent who supervised plugging of this well Lee Massey
Producing formation Chase Depth to top 2925 Bottom 2965 Total Depth of Well 2965 Feet
Show depth and thickness of all water, oil and gas formations.

OIL, GAS OR WATER RECORDS

CASING RECORD

| FORMATION | CONTENT | FROM | TO | SIZE | PUT IN | PULLED OUT |
|-----------|---------|------|------|-------|--------|------------|
| Chase | water | 2925 | 2936 | 8-5/8 | 233 | none |
| | | | | 4-1/2 | 2964 | 1635 |
| | | | | | | |
| | | | | | | |
| | | | | | | |
| | | | | | | |
| | | | | | | |

Describe in detail the manner in which the well was plugged, indicating where the mud fluid was placed and the method or methods used in introducing it into the hole. If cement or other plugs were used, state the character of same and depth placed, from _____ feet to _____ feet for each plug set.

Pump 15 sx cement and 1 sk hulls to 2825' - shoot off 4-1/2" @ 1630'. Pump 35 sx cement to 283' to 183' - fill hole with mud fluid to 33 feet - put 10 sx cement from 33 feet to 3'. Cut off 8-5/8" casing - weld plate on top 3' below surface.

RECEIVED
STATE CORPORATION COMMISSION
SEP 18 1974
CONSERVATION DIVISION
Wichita, Kansas

(If additional description is necessary, use BACK of this sheet)

Name of Plugging Contractor Sargent Casing Pulling
Address Box 506; Liberal, Kansas 67901

STATE OF KANSAS, COUNTY OF SEWARD, ss.
R. L. Higginbottom (employee of owner) or ~~landowner~~ of the above-described well, being first duly sworn on oath, says: That I have knowledge of the facts, statements, and matters herein contained and the log of the above-described well as filed and that the same are true and correct. So help me God.

(Signature) [Signature]
Box 6, Liberal, Kansas 67901 (Address)

SUBSCRIBED AND SWORN to before me this 10th day of September, 19 74

A. J. PARNELL
STATE NOTARY PUBLIC
My Commission Expires June 6, 1977

[Signature]
Notary Public.

15-071-20031-00-00

RECEIVED
STATE CORPORATION COMMISSION

JUL 23 1974

CONSERVATION DIVISION
Wichita, Kansas

STERLING DRILLING COMPANY
P. O. Box 129
Sterling, Kansas 67579

Well log ----- WEAR "A" #1
Located: C NE, Section 31-19S-40W, Greeley County, Kansas

OWNER: Dorchester Exploration, Inc.
ROTARY DRILLING CONTRACTOR: Sterling Drilling Company

COMMENCED: September 15, 1973
COMPLETED: September 19, 1973

TOTAL DEPTH: 2965'

| <u>LOG</u> | |
|-------------|------------------|
| 0 - 237 | Sand and Clay |
| 237 - 1930 | Shale |
| 1930 - 2190 | Salt |
| 2190 - 2225 | Shale and Shells |
| 2225 - 2477 | Shale |
| 2477 - 2499 | Anhydrite |
| 2499 - 2570 | Shale |
| 2570 - 2680 | Lime and Shale |
| 2680 - 2805 | Shale and Shells |
| 2805 - 2920 | Shale and Lime |
| 2920 - 2945 | Lime |
| 2945 - 2965 | Lime and Shale |

CASING RECORD

Ran 7 joints 8 5/8" casing, 221.85' pipe cemented at 233' K.B. with 100 sacks Howco light with 3% cc, followed with 100 sacks Pozmix "A", 3% cc. Plug down at 3:30 PM, 9-15-73.

Ran 85 joints 4 1/2" OD casing, 2968' cemented at 2964' with 250 sacks Pozmix, 10% salt. Plug down at 8:00 PM, 9-19-73.

*Original + 1
to Midland
9/27/73*