

15-071-20008-00-00

STATE OF KANSAS  
STATE CORPORATION COMMISSION


Form CP-4

WELL PLUGGING RECORD

Give All Information Completely  
Make Required Affidavit  
Mail or Deliver Report to:  
Conservation Division  
State Corporation Commission  
211 No. Broadway  
Wichita, Kansas

Greeley County, Sec. 3 Twp. 19S Rge. 10W (E) (W)  
Location as "NE/CNWxSWx" or footage from lines 1980' FWL - 1980' ESL, S<sup>1</sup>/<sub>4</sub>  
Lease Owner Pierce and Dehlinger  
Lease Name A. G. Fecht #1 Well No. \_\_\_\_\_  
Office Address 201 V and J Towers, Midland, Texas 79701  
Character of Well (completed as Oil, Gas or Dry Hole) Dry Hole  
Date well completed December 22, 1971 19\_\_\_\_  
Application for plugging filed December 21, 1971 19\_\_\_\_  
Application for plugging approved December 21, 1971 19\_\_\_\_  
Plugging commenced 8:00 PM, December 21, 1971 19\_\_\_\_  
Plugging completed 12:15 AM, December 22, 1971 19\_\_\_\_  
Reason for abandonment of well or producing formation Dry Hole

NORTH

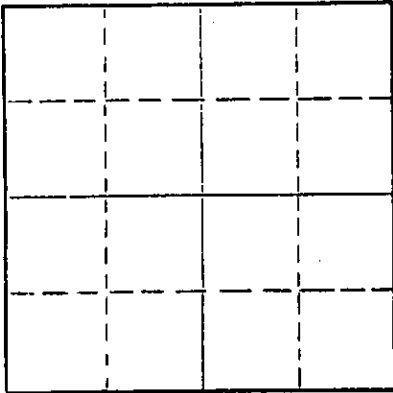

Locate well correctly on above  
Section Plat

If a producing well is abandoned, date of last production \_\_\_\_\_ 19\_\_\_\_  
Was permission obtained from the Conservation Division or its agents before plugging was commenced? Yes

Name of Conservation Agent who supervised plugging of this well W. L. Nichols  
Producing formation \_\_\_\_\_ Depth to top \_\_\_\_\_ Bottom \_\_\_\_\_ Total Depth of Well 5460 Feet  
Show depth and thickness of all water, oil and gas formations.

OIL, GAS OR WATER RECORDS

CASING RECORD

FORMATION	CONTENT	FROM	TO	SIZE	PUT IN	PULLED OUT
		<u>8 x 5/8"</u>		<u>8 5/8"</u>	<u>405'</u>	<u>None</u>

Describe in detail the manner in which the well was plugged, indicating where the mud fluid was placed and the method or methods used in introducing it into the hole. If cement or other plugs were used, state the character of same and depth placed, from \_\_\_\_\_ feet to \_\_\_\_\_ feet for each plug set.

Filled hole with heavy mud.  
Heavy mud to 1175' and 110 sacks 50/50 Pozmix.  
Heavy mud to 1435 and 30 sacks 50/50 Pozmix.  
Heavy mud to 140' and 1/2 sack Hills and D.H.P. and  
10 sacks 50/50 Pozmix.

RECEIVED  
STATE CORPORATION COMMISSION  
JAN 5 1972  
CONSERVATION DIVISION  
Wichita, Kansas

(If additional description is necessary, use BACK of this sheet)  
Name of Plugging Contractor STERLING DRILLING COMPANY  
Address P. O. Box 129, Sterling, Kansas 67579

STATE OF KANSAS, COUNTY OF RICE, ss.  
Bernard Laudermilk, Asst. Secretary (employee of owner) or (owner or operator) of the above-described well, being first duly sworn on oath, says: That I have knowledge of the facts, statements, and matters herein contained and the log of the above-described well as filed and that the same are true and correct. So help me God. STERLING DRILLING COMPANY

(Signature) Bernard Laudermilk  
Bernard Laudermilk, Asst. Secretary  
P. O. Box 129, Sterling, Kansas 67579  
(Address)

Subscribed and sworn to before me this 27th day of December, 19 71



Charles M. Hall  
Notary Public.

15-071-20008-00-00

STERLING DRILLING COMPANY  
P. O. Box 129  
Sterling, Kansas 67579

WELL LOG ----- A. G. FECHT #1

Located: 1980' FWL, 1980 FSL, SW/4, Sec. 3-19S-40W,  
Greeley County, Kansas

OWNER: Pierce and Dehlinger  
ROTARY DRILLING CONTRACTOR: Sterling Drilling Company

COMMENCED: December 6, 1971  
COMPLETED: December 22, 1971

TOTAL DEPTH: 5460'

LOG

0 - 440	Sand
440 - 800	Shale
800 - 1425	Sand and Shale
1425 - 1610	Shale and Lime
1610 - 2371	Shale and Sand
2371 - 2889	Shale and Lime
2889 - 2914	Lime
2914 - 2940	Sand and Shale
2940 - 3050	Lime, Sand - Shale
3050 - 4120	Lime and Shale
4120 - 4215	Lime
4215 - 4435	Lime and Shale
4435 - 4528	Lime
4528 - 4695	Lime and Shale
4695 - 4785	Lime
4785 - 4950	Lime and Shale
4950 - 5094	Sand and Shale
5094 - 5460	Lime

CASING RECORD

Ran 12 joints 8 5/8" 24# (388.33')  
Set at 405' K.B. Cemented with 300  
sacks cement 3% c.c. Plug down at  
11:15 AM, 12-7-71.

Plugged.

RECEIVED  
STATE CORPORATION COMMISSION  
JAN 5 1972  
CONSERVATION DIVISION  
Wichita, Kansas