


15-071-20004-000

Give All Information Completely
Make Required Affidavit
Mail or Deliver Report to:
Conservation Division
State Corporation Commission
211 No. Broadway
Wichita, Kansas

WELL PLUGGING RECORD

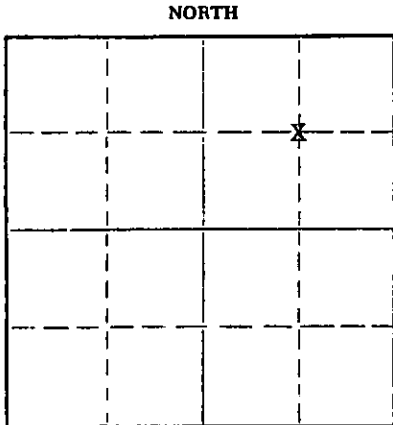

Locate well correctly on above Section Plat

Greeley County, Sec. 28 Twp. 19S Rge. (E) 40 (W)
Location as "NE/CNW/SE/SW" or footage from lines C NE/4
Lease Owner Brooks Hall Oil Corporation
Lease Name Thompson Well No. 1
Office Address 1710 Liberty Bank Building, Oklahoma City, Oklahoma
Character of Well (completed as Oil, Gas or Dry Hole) Dry Hole
Date well completed August 31 19 68
Application for plugging filed 19
Application for plugging approved (Approval given orally) 19
Plugging commenced September 1 19 68
Plugging completed September 1 19 68
Reason for abandonment of well or producing formation -

If a producing well is abandoned, date of last production - 19
Was permission obtained from the Conservation Division or its agents before plugging was commenced? Yes

Name of Conservation Agent who supervised plugging of this well W. L. Nichols
Producing formation None Depth to top Bottom Total Depth of Well 5405 Feet
Show depth and thickness of all water, oil and gas formations.

OIL, GAS OR WATER RECORDS

CASING RECORD

FORMATION	CONTENT	FROM	TO	SIZE	PUT IN	PULLED OUT
None				8-5/8"	401'	None

Describe in detail the manner in which the well was plugged, indicating where the mud fluid was placed and the method or methods used in introducing it into the hole. If cement or other plugs were used, state the character of same and depth placed, from feet to feet for each plug set.

Spotted 125 cu ft 50-50 pozmix with 6% gel @ 1175-1602'; filled with mud laden materials; placed 25 cu ft at 420-314'; filled with mud laden materials; then placed 10 cu ft from 40' to surface.

STATE RECEIVED
CONSERVATION DIVISION
SEP 5 1968
Wichita, Kansas

(If additional description is necessary, use BACK of this sheet)
Name of Plugging Contractor Service Drilling Company
Address 406 South Boulder, Tulsa, Oklahoma

STATE OF OKLAHOMA, COUNTY OF OKLAHOMA, ss.
Bill Newport (employee of owner) or (owner) of the above-described

well, being first duly sworn on oath, says: That I have knowledge of the facts, statements, and matters herein contained and the log of the above-described well as filed and that the same are true and correct. So help me God.

(Signature) *Bill Newport*
1710 Liberty Bank Building
Oklahoma City, Oklahoma
(Address)

SUBSCRIBED AND SWORN TO before me this 4th day of September, 19 68

My commission expires Dec. 8, 1970 *Mary J Myers* Notary Public.