


Give All Information Completely  
Make Required Affidavit  
Mail or Deliver Report to:  
Conservation Division  
State Corporation Commission  
211 No. Broadway  
Wichita, Kansas

Greology County. Sec. 25 Twp. 12 Rge. 40W (E) (W)

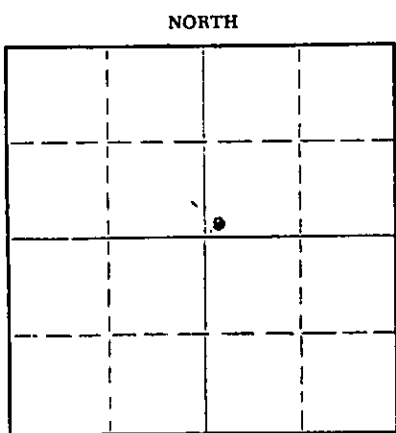

Locate well correctly on above Section Plat

Location as "NE/CNW/SW" or footage from lines SW NE  
Lease Owner Madson Oil and Gas Co.  
Lease Name Floyd Well No. -  
Office Address 1406 Normal Building Oklahoma City, Okla.  
Character of Well (completed as Oil, Gas or Dry Hole) Dry Hole  
Date well completed \_\_\_\_\_ 19\_\_\_\_  
Application for plugging filed 5-25 1965  
Application for plugging approved 5-27 1965  
Plugging commenced 6-15 1965  
Plugging completed 6-23 1965  
Reason for abandonment of well or producing formation Non Commercial

If a producing well is abandoned, date of last production \_\_\_\_\_ 19\_\_\_\_  
Was permission obtained from the Conservation Division or its agents before plugging was commenced? Yes

Name of Conservation Agent who supervised plugging of this well W. L. Nichols  
Producing formation Perforations 2044' Depth to top \_\_\_\_\_ Bottom \_\_\_\_\_ Total Depth of Well 2201 Feet  
Show depth and thickness of all water, oil and gas formations.

OIL, GAS OR WATER RECORDS

CASING RECORD

FORMATION	CONTENT	FROM	TO	SIZE	PUT IN	PULLED OUT
				8 5/8	232	None
				12	2031	2240

Describe in detail the manner in which the well was plugged, indicating where the mud fluid was placed and the method or methods used in introducing it into the hole. If cement or other plugs were used, state the character of same and depth placed, from \_\_\_\_\_ feet to \_\_\_\_\_ feet for each plug set.

Plug perforations off with 20 sacks cement with pump truck and stop plug at 2716'. Pull casing and fluid was at 375'. Make bridge at 375' and 20 sacks of cement. Mud to 220' and 20 sacks of cement. Mud to 35' and bridge and 10 sacks cement to collar. Complete 6-23-65

RECEIVED  
STATE CORPORATION COMMISSION

JUL 12 1965

07-12-65

CONSERVATION DIVISION  
Wichita, Kansas

(If additional description is necessary, use BACK of this sheet)

Name of Plugging Contractor Sargent's Casing Pulling Service  
Address Box 506 Liberal, Kansas

STATE OF KANSAS, COUNTY OF SEWARD, ss.  
Robert Sargent (employee of owner) or (owner or operator) of the above-described well, being first duly sworn on oath, says: That I have knowledge of the facts, statements, and matters herein contained and the log of the above-described well as filed and that the same are true and correct. So help me God.

(Signature) Robert Sargent  
Box 506 Liberal Kan  
(Address)

SUBSCRIBED AND SWORN TO before me this 10th day of July, 1965

B. M. Hanson Notary Public.

My commission expires July 13, 1967

15 071-00028-00-50

LEASE: FLOYD UNIT #1  
OWNER: WALSON OIL & GAS COMPANY  
CONTRACTOR: EARL F. WAKEFIELD  
COMM: 3-31-63 COMP: 4-4-63

LOCATION: SW NE  
SECTION 25-192-40W  
CASING: 8 5/8" Set at 232'  
2 1/2" Set at 2881'

Surface Soil	30
Sand and Clay	100
Shale	205
Blue Shale	233
Clay and shale	720
Shale and Shells	1810
Salt and Shells	2130
Shale and Shells	2180
Shale, Shells, Anhydrite	2420
Shale	2478
Anhydrite	2497
Shale	2561
Lime and Shale	2881
T.D.	2881

FILED  
STATE CORPORATION COMMISSION  
JUL 12 1963  
CONSERVATION DIVISION  
WICHITA, KANSAS

STATE OF KANSAS )  
COUNTY OF SEDGWICK ) SS

I hereby certify that the above is a true and correct copy of the log on the FLOYD UNIT #1 well, located SW NE SECTION 25-192-40W, Osceola County, Kansas.

EARL F. WAKEFIELD

By Earl F. Wakefield

Subscribed and sworn before me this 12th day of April, 1963.

My commission expires:  
January 25, 1965

Wanda W. Riley  
WANDA W. RILEY NOTARY