

STATE OF KANSAS  
STATE CORPORATION COMMISSION

WELL PLUGGING RECORD

Give All Information Completely  
Make Required Affidavit  
Mail or Deliver Report to  
Conservation Division  
State Corporation Comm.  
245 North Water  
Wichita, KS 67202

Greeley County, Sec. 9 Twp. 19 Rge. 40 ~~W~~  
Location as "NE/CNW $\frac{1}{4}$ SW $\frac{1}{4}$ " or footage from lines  
C SW SW NE


Lease Owner Kansas Nebraska Natural Gas Co.  
Lease Name Clift Well No. 1

Office Address Lakin, Kansas 67860  
Character of Well (Completed as Oil, Gas or Dry Hole)  
Gas

Date Well completed 19 54  
Application for plugging filed 9-11 1978  
Application for plugging approved 9-12 1978  
Plugging commenced 9-23 1978  
Plugging completed 9-29 1978

Reason for abandonment of well or producing formation  
Non Commercial Value  
If a producing well is abandoned, date of last production  
None 19

Was permission obtained from the Conservation Division or  
its agents before plugging was commenced? Yes

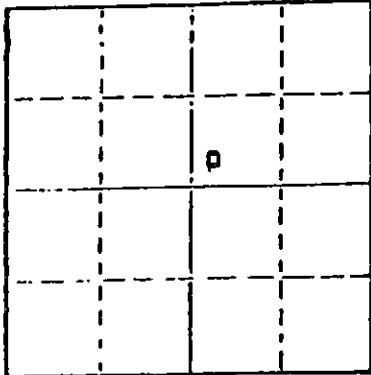

Locate well correctly on above  
Section Plot

Name of Conservation Agent who supervised plugging of this well Mr. Balthazor  
Producing formation Hugoton Depth to top 2884' Bottom 2908' Total Depth of Well 2917'  
Show depth and thickness of all water, oil and gas formations.

OIL, GAS OR WATER RECORDS

CASING RECORD

FORMATION	CONTENT	FROM	TO	SIZE	PUT IN	PULLED OUT
Surface				8 5/8"	255'	0'
Production				5 1/2"	2917'	2166'

Describe in detail the manner in which the well was plugged, indicating where the mud fluid  
was placed and the method or methods used in introducing it into the hold. If cement or other  
plugs were used, state the character of same and depth placed, from \_\_\_\_\_ feet to  
\_\_\_\_\_ feet for each plug set.

Pumped 2 sacks hulls & 15 sacks cement to 2760' & pressured to 750 lbs.  
Displaced to 1400'  
Pumped 25 sacks cement 1400' to 1320'  
Displaced to 250'  
Pumped 30 sacks cement 250' to 150'  
Displaced to 40'  
Put bridge & 10 sacks cement 40' to 0'  
Cut off 8 5/8" 42" below ground level.

RECEIVED  
STATE CORPORATION COMMISSION  
10-05-78  
OCT 5 1978

(If additional description is necessary, use BACK of this sheet) CONSERVATION DIVISION  
MICHIGAN, Kansas

Name of Plugging Contractor Midwest Casing Pulling  
Box F, Sublette, Kansas 67877 Kansas Permit #766

STATE OF KANSAS COUNTY OF Haskell, ss.  
I Edgar J. Eves (employee of owner) or (owner or operator)  
of the above-described well, being first duly sworn on oath, says: That I have knowledge of  
the facts, statements, and matters herein contained and the log of the above-described well  
as filed and that the same are true and correct. So help me God.

(Signature) Edgar J. Eves  
Box F, Sublette, Kansas 67877  
(Address)

SUBSCRIBED AND SWORN TO before me this 29th day of September, 1978

Sondra L. Eves  
Notary Public.

My commission expires 12-6-80

