

15-071-00014-00-00
WELL PLUGGING RECORD


STATE OF KANSAS
STATE CORPORATION COMMISSION

Give All Information Completely
Make Required Affidavit
Mail or Deliver Report to:
Conservation Division
State Corporation Commission
211 No. Broadway
Wichita, Kansas

Greeley County. Sec. 9 Twp. 19S Rge. 10 (EX) (W)

Location as "NE/CNWxSWx" or footage from lines. CSW SW
Lease Owner Van-Grisso Oil Company et al
Lease Name Clift Well No. 1
Office Address 1012 City National Bldg., Okla City 2, Okla.
Character of Well (completed as Oil, Gas or Dry Hole) Dry Hole
Date well completed July 28, 1956
Application for plugging filed August 7, 1956
Application for plugging approved August 7, 1956
Plugging commenced November 14, 1956
Plugging completed November 14, 1956
Reason for abandonment of well or producing formation Dry Hole

NORTH

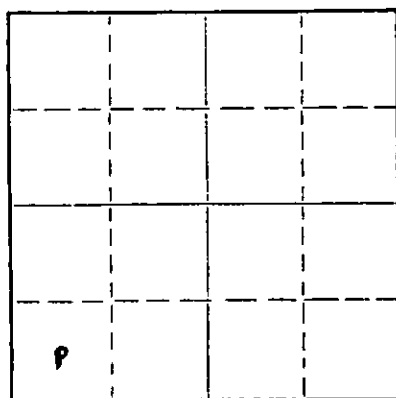

Locate well correctly on above
Section Plat

If a producing well is abandoned, date of last production 19____
Was permission obtained from the Conservation Division or its agents before plugging was commenced? Yes

Name of Conservation Agent who supervised plugging of this well R. M. Brundege
Producing formation dry hole Depth to top Bottom Total Depth of Well 5395 Feet
Show depth and thickness of all water, oil and gas formations.

OIL, GAS OR WATER RECORDS

CASING RECORD

FORMATION	CONTENT	FROM	TO	SIZE	PUT IN	PULLED OUT
				13 3/8"	186'	
				8 5/8"	2535'	
				5 1/2"	3174'	

Describe in detail the manner in which the well was plugged, indicating where the mud fluid was placed and the method or methods used in introducing it into the hole. If cement or other plugs were used, state the character of same and depth placed, from feet to feet for each plug set.

Surface Pipe - 13 3/4" @ 285' c.w.c. 8 5/8" @ 2536' - 200 Sacks Cement
5 1/2 @ 3174' - 150 Sacks Cement. Plugged Back 3107, Top Perforation @ 2986'
Sand to 2975' - 5 sacks cement.
Pull 5 1/2" pipe and plug at 2520' - 10 sacks cement.
Pull 8 5/8" pipe and mud and Rotary Bushing to 285' - 30 Sacks of cement.
Mud and Rotary Bushing to 20' and 20 sacks cement to base of cellar.

RECEIVED
STATE CORPORATION COMMISSION
01-22-71 JAN 22 1971
CONSERVATION DIVISION
Wichita, Kansas

(If additional description is necessary, use BACK of this sheet)
Name of Plugging Contractor R & D Casing Pulling Company
Address Ellinwood, Kansas

STATE OF Oklahoma COUNTY OF Oklahoma, ss.
(employee of owner) or (owner or operator) of the above-described well, being first duly sworn on oath, says: That I have knowledge of the facts, statements, and matters herein contained and the log of the above-described well as filed and that the same are true and correct. So help me God.

(Signature) D. L. Hyatt
D. L. Hyatt, Geologist
Oklahoma City, Oklahoma
(Address)

SUBSCRIBED AND SWORN TO before me this 15th day of May 19 57


My commission expires January 7, 1961
Mary Pylant Notary Public.

STATE OF KANSAS
STATE CORPORATION COMMISSION

Give All Information Completely
Make Required Affidavit
Mail or Deliver Report to:
Conservation Division
State Corporation Commission
211 No. Broadway
Wichita, Kansas

15-071-00014-00-00
WELL PLUGGING RECORD

NORTH

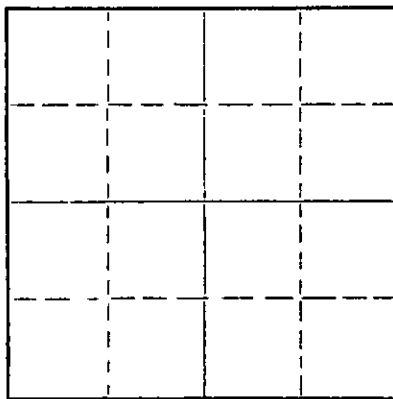

Locate well correctly on above
Section Plat

Greeley County, Sec. 9 Twp. 19 Rge. 40 ~~XX~~ (W)

Location as "NE/CNW*SW*" or footage from lines CSW SW
Lease Owner Van-Grisso Oil Company
Lease Name Clift Well No. 1
Office Address 1012 City National Bldg., Okla City 2, Okla.
Character of Well (completed as Oil, Gas or Dry Hole) Dry Hole
Date well completed July 28, 1956
Application for plugging filed October 23, 1956
Application for plugging approved October 23, 1956
Plugging commenced November 14, 1956
Plugging completed November 14, 1956
Reason for abandonment of well or producing formation _____

If a producing well is abandoned, date of last production _____ 19____
Was permission obtained from the Conservation Division or its agents before plugging was commenced? Yes

Name of Conservation Agent who supervised plugging of this well R. M. Brundege
Producing formation _____ Depth to top _____ Bottom _____ Total Depth of Well 5395 Feet
Show depth and thickness of all water, oil and gas formations.

OIL, GAS OR WATER RECORDS

CASING RECORD

FORMATION	CONTENT	FROM	TO	SIZE	PUT IN	PULLED OUT

Describe in detail the manner in which the well was plugged, indicating where the mud fluid was placed and the method or methods used in introducing it into the hole. If cement or other plugs were used, state the character of same and depth placed, from _____ feet to _____ feet for each plug set.

Surface Pipe - 13 3/4 @ 285 c.w.c. 8 5/8" @ 2536 - 200 sacks cement.
5 1/2" @ 3174 - 150 sacks cement. Plugged back 3107. Top perforation
@ 2986'. Sand to 2975 - 5 sacks cement. Pulled 5 1/2" pipe and set
plug at 2520' - 10 sacks cement. Pulled 8 5/8" pipe and mud and R.B.
to 285' - 30 sacks cement. Mud and R.B. to 20' and 20 sacks cement to
base of cellar.

05-07-58

(If additional description is necessary, use BACK of this sheet)
Name of Plugging Contractor R & D Casing Pulling Company
Address Ellinwood, Kansas

STATE OF KANSAS, COUNTY OF BARTON, ss.
J. W. Railback (employee of owner) or (~~owner or operator~~) of the above-described well, being first duly sworn on oath, says: That I have knowledge of the facts, statements, and matters herein contained and the log of the above-described well as filed and that the same are true and correct. So help me God.

(Signature) J. W. Railback
Box 574 Ellinwood, Kan
(Address)

SUBSCRIBED AND SWORN TO before me this 6 day of May, 1958
Delmer L. Posten
Notary Public.

My commission expires _____

PLUGGING
FILED SEC 9 T 19 R 40W
BOOK PAGE 87 LINE 18

WELL RECORD

OPERATOR: VAN-GRISSE OIL COMPANY, 1012 City Nat'l. Bldg., Okla. City 2, Okla.
 LEASE: CLIFT WELL NO. 1
 LOCATION: C SW SW SEC. 9-19S-40W., COMMENCED: July 3, 1956
 COUNTY: GREELEY COUNTY, KANSAS COMPLETED: July 28, 1956
 ELEVATION: KB: 3616' (except for plugging operations)
 CHARACTER OF WELL: Dry and abandoned
 CASING RECORD: Set 13 3/8" @ 186' w/160 sacks cement
 8 5/8" @ 2535' w/200 sacks cement
 5 1/2" @ 3174' w/150 sacks cement

LOG

Clay-sand	120
Shale	1710
Shale-Red Bed	1841
Shale	2406
Red Bed-Shale	2514
Anhydrite	2530
Shale	2878
Sand-Lime	2979
Sand-Shale w/ lime	3037
Sand-Shale	3163
Shale-Lime	3241
Lime-Shale	3466
Lime	3874
Lime-Sandy Shale	3950
Lime	4770
Lime-Shale	4977
Shale-Lime	5032
Sandy Shale-Sand	5059
Shale-Lime	5192
Shale-Lime	5256
Shale-Lime-Sand	5287
Lime	5352
Lime-Shale	5370
Lime	5395 R.T.D.

SAMPLE TOPS:

Topeka 3690 (-74)
 Morrow 4961 (-1345)

STATE OF OKLAHOMA: OKLAHOMA COUNTY.....ss

Don L. Hyatt (employee of Van-Grisso Oil Company) operator of the well above described, being first duly sworn on oath, says: That I have knowledge of the facts, statements and matters herein contained and the log of the above described well, as set forth above, and the same are true and correct. So help me God.

Don L. Hyatt
 Don L. Hyatt

1012 City Nat'l. Bldg., Okla. City,
 Oklahoma

Subscribed and sworn to before me this 15th day of May, 1957.

My commission expires Jan. 7, 1961

Mary Pyrant
 Mary Pyrant - Notary Public

15-071-00014-00-00

NO. 1 LIFT

WELL LOG

Location: Str. SW, 9-193-40W
Greeley County, Kansas

Commenced: July 3, 1956

Operator: Van-Crisso Oil Company
1012 City National Building
Oklahoma City, Oklahoma

Completed: July 29, 1956 (v/rty)

Elevation: 3016 FT

Contractor: Messman-Rinehart Drilling Company
501 Petroleum Building, Wichita, Kans.

Productions:

Casing Records: 13 3/8" @ 186' w/160 sacks cement
8 5/8" @ 2535' w/200 sacks cement
5 1/2" @ 3174' w/150 sacks cement

...L O G....

Clay-Sand	120
Shale	1710
Shale-dud Fed	1841
Shale	2406
Red Sed-Shale	2514
Anhydrite	2530
Shale	2878
Sand-Lime	2979
Sand-Shale w/Lime	3037
Sand-Shale	3163
Shale-Lime	3241
Lime-Shale	3466
Lime	3674
Lime-sandy shale	3950
Lime	4770
Lime-Shale	4977
Shale-Lime	5032
Sandy shale-sand	5059
Shale-Lime	5190
Lime	5192
Sand-Lime	5256
Shale-Lime-Sand	5287
Lime	5352
Lime-shale	5370
Lime	5395 R.T.D.

INDEXED
STATE OIL & GAS COMMISSION

APR 22 1957

CONSERVATION DIVISION
Wichita, Kansas

Sample Tops:

Topeka 3690 (-74)
Kerrow 4761 (-1345)

The undersigned, MESSMAN-RINEHART DRILLING COMPANY, hereby certifies that the above log is a true and correct log of the formation encountered in drilling the above well as reflected by the Daily Drilling Report.

MESSMAN-RINEHART DRILLING COMPANY

BY: J. A. Gilliland
J. A. Gilliland

Subscribed and sworn to before me this
6th day of August 1956.

Joanette L. Lewis
Notary Public

My Commission Expires: November 5, 1958

PLUGGING
FILE SEC 9 T 19 R 40W
BOOK PAGE 87 LINE 18