

15-071-20262-0000

STATE OF KANSAS
STATE CORPORATION COMMISSION

WELL PLUGGING RECORD

Give All Information Completely
Make Required Affidavit
Mail or Deliver Report to
Conservation Division
State Corporation Comm.
245 North Water
Wichita, KS 67202

Greeley County, Sec. 36 Twp. 19S Rge. 41 E/W
Location as "NE/CNW $\frac{1}{2}$ SW $\frac{1}{2}$ " or footage from lines
C NE NW


Lease Owner PAR Petroleum, Inc.
Lease Name Brinkman Well No. 1
Office Address P. O. Box 280, Liberal, Kansas 67901
Character of Well (Completed as Oil, Gas or Dry Hole)
completed as gas

Date Well completed May 2 19 82
Application for plugging filed Verbal Agreement 19
Application for plugging approved 19
Plugging commenced September 27 19 82
Plugging completed September 27 19 82
Reason for abandonment of well or producing formation
water encroachment

If a producing well is abandoned, date of last production
August 23 19 82

Was permission obtained from the Conservation Division or
its agents before plugging was commenced? yes

Name of Conservation Agent who supervised plugging of this well Paul Luthi
Producing formation Lower Winfield Depth to top 2878' Bottom 2908' Total Depth of Well 3198'
Show depth and thickness of all water, oil and gas formations.

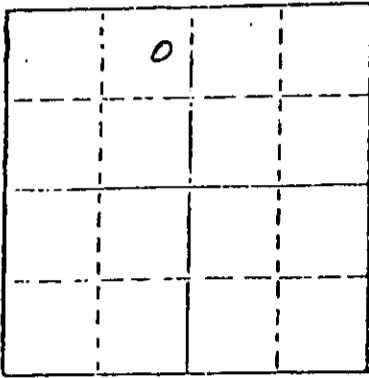

Locate well correctly on above
Section Plot

OIL, GAS OR WATER RECORDS

CASING RECORD

FORMATION	CONTENT	FROM	TO	SIZE	PUT IN	PULLED OUT
				8 5/8"	262'	None
				4 1/2"	2960'	None

Describe in detail the manner in which the well was plugged, indicating where the mud fluid was placed and the method or methods used in introducing it into the hold. If cement or other plugs were used, state the character of same and depth placed, from _____ feet to _____ feet for each plug set.

Cast iron bridge plug set at 2830'. Ran in hole with tubing to 2829'; loaded casing with mud; pumped 40 sx cement through tubing placing cement plug from 2830' to 2357'; pumped 10 sx cement through tubing at 800' placing cement plug from 800' to 682'; pumped 20 sx cement through tubing at 300' placing cement plug from 300' to 63'; pumped 5 sx cement through tubing at 40' placing cement plug from 40' to surface.

(If additional description is necessary, use BACK of this sheet)

Name of Plugging Contractor Halliburton Services

STATE OF Kansas COUNTY OF Seward, ss.
Rodney R. Reynolds (employee of owner) or (owner or operator)

of the above-described well, being first duly sworn on oath, says: That I have knowledge of the facts, statements, and matters herein contained and the log of the above-described well as filed and that the same are true and correct. So help me God.

(Signature) Rodney R. Reynolds
P. O. Box 280, Liberal, Kansas 67901
(Address)

SUBSCRIBED AND SWORN TO before me this 30th day of September, 19 82



Marjorie A. Kennedy
Notary Public.

My commission expires 1-8-84