

15-071-20060-00-00

STATE OF KANSAS
STATE CORPORATION COMMISSION


Form CP-4

Give All Information Completely
Make Required Affidavit
Mail or Deliver Report to:
Conservation Division
State Corporation Commission

WELL PLUGGING RECORD

P. O. Box 17027
Wichita, Kansas 67217
NORTH

Greeley County, Sec. 32 Twp. 19 Rge. (E) 41 (W)
Location as "NE/CNW&SW&" or footage from lines C NE/4
Lease Owner Dorchester Exploration Incorporated
Lease Name Sadow Well No. 1
Office Address 1204 Vaughn Bldg; Midland, Texas 79701
Character of Well (completed as Oil, Gas or Dry Hole) Dry Hole
Date well completed April 6, 1974 19
Application for plugging filed July 21, 1974 19
Application for plugging approved July 23, 1974 19
Plugging commenced August 14, 1974 19
Plugging completed August 15, 1974 19
Reason for abandonment of well or producing formation non-commercial
If a producing well is abandoned, date of last production none 19
Was permission obtained from the Conservation Division or its agents before plugging was commenced? Yes

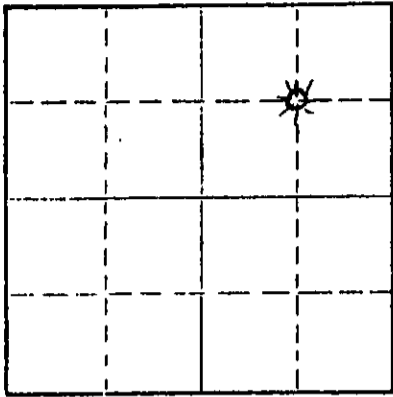

Locate well correctly on above Section Plat

Name of Conservation Agent who supervised plugging of this well Lee Massey
Producing formation Chase Depth to top 2884 Bottom 2898 Total Depth of Well 2950 Feet
Show depth and thickness of all water, oil and gas formations.

OIL, GAS OR WATER RECORDS

CASING RECORD

FORMATION	CONTENT	FROM	TO	SIZE	PUT IN	PULLED OUT
Chase	dry	2884	2898	8-5/8"	231	none
				4-1/2	2949	1251

Describe in detail the manner in which the well was plugged, indicating where the mud fluid was placed and the method or methods used in introducing it into the hole. If cement or other plugs were used, state the character of same and depth placed, from _____ feet to _____ feet for each plug set.

Pump 15 sx cement and 1 sk hulls from 2784 to 2900 - shoot off 4 1/2" casing at 1216' - pump 35 sx cement from 200' to 300' - fill hole with mud fluid to 33 feet - 10 sx cement from 33 feet to 3' - cut off 8-5/8" casing 3' below GL - weld plate on top.

RECEIVED
STATE CORPORATION COMMISSION
SEP 18 1974
CONSERVATION DIVISION
Wichita, Kansas

(If additional description is necessary, use BACK of this sheet)

Name of Plugging Contractor Sargent Casing Pulling
Address Box 506; Liberal, Kansas 67901

STATE OF KANSAS, COUNTY OF SEWARD, ss.
R. L. Higginbottom (employee of owner) or (owner or operator) of the above-described well, being first duly sworn on oath, says: That I have knowledge of the facts, statements and matters herein contained and the log of the above-described well as filed and that the same are true and correct. So help me God.

(Signature) R. L. Higginbottom
Box 6; Liberal, Kansas 67901
(Address)

SUBSCRIBED AND SWORN to before me this 10th day of September, 1974

A. J. PARNELL
STATE NOTARY PUBLIC
Seward County, Kansas
My Commission Expires June 6, 1977

A. J. Parnell
Notary Public.

15-071-20060-00-00

STERLING DRILLING COMPANY
P. O. Box 129
Sterling, Kansas 67579

WELL LOG ----- SANDOW #1
Located: C NE/4, Section 32-19S-41W, Greeley County, Kansas

OWNER: Dorchester Exploration, Inc.
ROTARY DRILLING CONTRACTOR: Sterling Drilling Company

COMMENCED: March 19, 1974
COMPLETED: March 24, 1974

TOTAL DEPTH: 2950'

<u>LOG</u>		<u>CASING RECORD</u>
0 - 135	Sand and Clay	Ran 5 joints 8 5/8", 219.32' set at 231' K.B. with 160 sacks Common with 2% cc. Plug down at 6:45 PM, 3-19-74.
135 - 233	Shale	
233 - 360	Sand and Shale	
360 - 1210	Shale	
1210 - 1913	Shale and Sand	
1913 - 2285	Salt	
2285 - 2445	Shale	
2445 - 2467	Anhy.	
2467 - 2484	Shale	
2484 - 2625	Lime and Shale	
2625 - 2685	Shale and Shells	
2685 - 2925	Lime and Shale	
2925 @ 2950	Lime	Ran 91 joints of mixed new and used 4 1/2" casing, set at 2949' K.B. Cemented with 200 sacks Common. Plug down at 4:15 AM, 3-24-74.