


STATE OF KANSAS  
STATE CORPORATION COMMISSION

Give All Information Completely  
Make Required Affidavit  
Mail or Deliver Report to:  
Conservation Division  
State Corporation Commission  
211 No. Broadway  
Wichita, Kansas

15-071-00032-00-00

WELL PLUGGING RECORD

NORTH

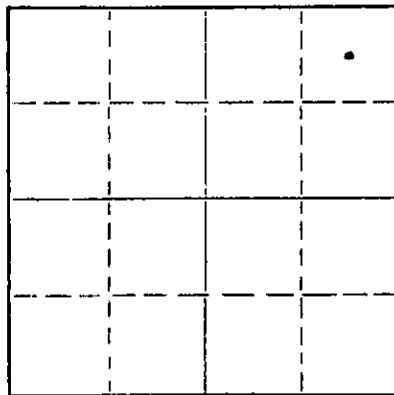

Locate well correctly on above  
Section Plat

Greeley County. Sec. 19 Twp. 19 Rge. (X) 41 (W)  
Location as "NE/CNW/SW" or footage from lines C NE NE  
Lease Owner Sun Oil Company  
Lease Name Bessie Pearson Well No. 1  
Office Address Box 1348, Tulsa, Okla.  
Character of Well (completed as Oil, Gas or Dry Hole) Dry Hole  
Date well completed Aug. 21 1965  
Application for plugging filed Aug. 21 1965  
Application for plugging approved Aug. 21 1965  
Plugging commenced Aug. 21 1965  
Plugging completed Aug. 21 1965  
Reason for abandonment of well or producing formation Dry Hole - No show.

If a producing well is abandoned, date of last production \_\_\_\_\_ 19\_\_\_\_  
Was permission obtained from the Conservation Division or its agents before plugging was commenced? Yes

Name of Conservation Agent who supervised plugging of this well W. L. Nichols, Moreland, Kansas  
Producing formation None Depth to top \_\_\_\_\_ Bottom \_\_\_\_\_ Total Depth of Well 4,075 Feet  
Show depth and thickness of all water, oil and gas formations.

OIL, GAS OR WATER RECORDS

CASING RECORD

FORMATION	CONTENT	FROM	TO	SIZE	PUT IN	PULLED OUT
None				8-5/8"	268.5'	None

Describe in detail the manner in which the well was plugged, indicating where the mud fluid was placed and the method or methods used in introducing it into the hole. If cement or other plugs were used, state the character of same and depth placed, from \_\_\_\_\_ feet to \_\_\_\_\_ feet for each plug set.

10.4# Mud 4,075' to 240'  
20 Sax cement 240' to 180' (In lower portion of 8-5/8" Casing)  
10.4# Mud 180' to 40' (In Upper Portion of 8-5/8" Casing)  
Set rubber plug at 40' w/ 1/2 sack hulls on top and filled to top of  
8-5/8" surface pipe w/10 sacks cement.  
8-5/8" Cut off 5 feet below ground level and steel plate welded on top.

Job completed 8 PM August 21, 1965

*Handwritten notes and stamps:*  
AUG 27 1965  
08-27-65  
CONSERVATION DIVISION  
WICHITA, KANSAS

(If additional description is necessary, use BACK of this sheet)

Name of Plugging Contractor Earl Wakefield Drilling  
Address 515 Union Center Bldg., Wichita, Kansas

STATE OF Oklahoma, COUNTY OF Tulsa, ss.  
J. H. Allen (employee of owner) or (owner or operator) of the above-described well, being first duly sworn on oath, says: That I have knowledge of the facts, statements, and matters herein contained and the log of the above-described well as filed and that the same are true and correct. So help me God.

(Signature) J. H. Allen  
Box 1348, Tulsa, Oklahoma  
(Address)

SUBSCRIBED AND SWORN TO before me this 26<sup>th</sup> day of August, 1965

My commission expires MAR 16 1968

Doris Sutterfield  
DORIS SUTTERFIELD Notary Public.



WELL LOG

SUN OIL COMPANY  
Bessie Pearson No. 1  
C NE NE  
Section 19, Twp. 19S, Rge 41W  
Greeley County, Kansas

15-071-00032-00-00

<u>FROM</u>	<u>TO</u>	<u>FORMATION</u>		
0	271	Soil, Sand, Shale	Spudded:	8-11-65
271	1370	Shale w/occ. Sand Streaks	Complete	8-21-65
1370	1834	Anhyd. & Shale	8-5/8" Cemented at 268½' with	
1834	2200	Gyp. & Shale	250 sax.	
2200	2500	Sand, Shale, Anhyd.		
2500	2665	Shale w/streaks limestone & Anhyd.		
2665	2860	Shale & Limestone		
2860	3220	Sand, Shale sand, Streaks shale		
3220	3492	Limestone w/shale streaks		
3492	3600	Shale, Sand, & Limestone	Formation Tops	
3600	3870	Limestone w/thin shale streaks	Waubunsee	3,492'
3870	3900	Shally sand	Topeka	3,754'
3900	4075	Limestone w/shale streaks	Oread	3,942'
			Heebner	4,031'

I hereby certify that the foregoing is a true and correct copy of the Bessie Pearson # 1 well log as recorded on the books of Sun Oil Company, Tulsa, Oklahoma.

*J. H. Allen*

J. H. Allen  
Ast. Prod. Supt.

STATE OF OKLAHOMA) SS  
COUNTY OF TULSA )

Subscribed and sworn to before me this 26th day of August, 1965.

*Doris Sutterfield*

Notary Public  
DORIS SUTTERFIELD

My Commission Expires: MAR 16 1968