


STATE OF KANSAS
STATE CORPORATION COMMISSION

Give All Information Completely
Make Required Affidavit
Mail or Deliver Report to:
Conservation Division
State Corporation Commission
211 No. Broadway
Wichita, Kansas

15-071-00003-00-00
WELL PLUGGING RECORD

NORTH

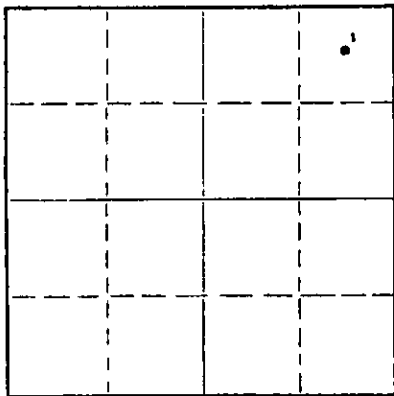

Locate well correctly on above
Section Plat

Greeley County, Sec. 15 Twp. 19-S Rge. (E) 41 (W)
Location as "NE/CNW/SW" or footage from lines C NE/4 NE/4
Lease Owner General Crude Oil Company
Lease Name B. B. Kucera Well No. 1
Office Address 107 Oil & Gas Building, Abilene, Texas
Character of Well (completed as Oil, Gas or Dry Hole) Dry Hole
Date well completed July 30, 19 59
Application for plugging filed July 30, (Verbal) 19 59
Application for plugging approved July 30, (Verbal) 19 59
Plugging commenced July 30, 19 59
Plugging completed July 31, 19 59
Reason for abandonment of well or producing formation Dry Hole

If a producing well is abandoned, date of last production 19
Was permission obtained from the Conservation Division or its agents before plugging was commenced? Yes, Verbal permission was granted.

Name of Conservation Agent who supervised plugging of this well A. D. Fabricius (Mr. Leiker on vacation)
Producing formation None Depth to top - Bottom - Total Depth of Well 3450 Feet
Show depth and thickness of all water, oil and gas formations.

OIL, GAS OR WATER RECORDS

CASING RECORD

FORMATION	CONTENT	FROM	TO	SIZE	PUT IN	PULLED OUT
Surface sands	water	Surface	70	8-5/8	229	None
Dakota		1138	1196		None	
Cimarron		2410	2503		None	
Herrington-Krider		2800	2825		None	
Winfield		2845	2849		None	
Upper Ft. Riley		2906	2914		None	
Lower Ft. Riley		2932	2943		None	
Admire		3305	3339		None	

Describe in detail the manner in which the well was plugged, indicating where the mud fluid was placed and the method or methods used in introducing it into the hole. If cement or other plugs were used, state the character of same and depth placed, from _____ feet to _____ feet for each plug set.

The hole was filled with heavy mud by pumping through open-ended drill pipe. The pipe was raised to a depth of 500 feet and 20 sacks of cement were mixed and pumped through the open-ended drill pipe to cover the interval from 435 to 500 feet. The drill pipe was then raised to a depth of 225 feet, leaving heavy mud from 225 to 435 feet. Another 20 sacks of cement were mixed and pumped through the open-ended drill pipe and covered the interval from 164 to 225 feet. The drill pipe was pulled from the hole leaving heavy mud from the surface to 225 feet. A wood plug was placed in the 8-5/8 inch surface pipe and pushed to a depth of 30 feet. Another 10 sacks of cement were mixed and pumped and filled the casing from the cellar to 30 feet. A steel cap was welded on the surface pipe, below plow depth, and the well was permanently plugged and abandoned.

Portland cement was used for all plugs and was mixed and pumped by Halliburton Oil Well Cementing Company.

AUG 10 1959

(If additional description is necessary, use BACK of this sheet)
Name of Plugging Contractor Halliburton Oil Well Cementing Company CONSERVATION DIVISION
Address Elkhart, Kansas Wichita, Kansas

STATE OF Texas, COUNTY OF Taylor, ss.
F. A. Hunter (employee of owner) or (owner or operator) of the above-described well, being first duly sworn on oath, says: That I have knowledge of the facts, statements, and matters herein contained and the log of the above-described well as filed and that the same are true and correct. So help me God.

(Signature) F. A. Hunter
107 Oil & Gas Building, Abilene, Texas (Address)

SUBSCRIBED AND SWORN TO before me this 6th day of August, 19 59

My commission expires June 1, 1961 Notary Public.

PLUGGING
FILE SEC 15 T 19 R 41W
BOOK PAGE 57 LINE 35

15-071-00003-00-00

CERTIFIED DRILLER'S LOG
General Crude Oil Company B. B. Kucera No. 1.
C NE/4 NE/4 Sec. 15, T-19-S, R-41-W
Greeley County, Kansas

REG
COMMISSION

AUG 10 1959

CONSERVATION DIVISION
Wichita, Kansas

<u>Depth</u>	<u>Formation</u>
0- 40	Surface sands
40- 170	Gyp rock and sand streaks
170- 230	Blue shale
230-1420	Shale and shells
1420-2400	Shale, sand and red beds
2400-2850	Shale and lime
2850-3450	Shale, lime and streaks of sand

A F F I D A V I T

STATE OF Texas, COUNTY OF Taylor SS,

I, F. A. Hunter of the General Crude
Oil Company, being first duly sworn on oath, state:

That I have knowledge of the facts, statements and matters
herein contained and that the same are true and correct.

F. A. Hunter

Subscribed and sworn to before me this 6th day of August,
1959.

Martha Wishert
Martha Wishert Notary Public

My Commission Expires:

June 1, 1961

PLUGGING
FILE SEC. 15T. R. 41W
BOOK PAGE 50 LINE 35