

15-171-20180-00-00

STATE OF KANSAS  
STATE CORPORATION COMMISSION


Form CP-4

Give All Information Completely  
Make Required Affidavit  
Mail or Deliver Report to:  
Conservation Division  
State Corporation Commission  
212 No. Market  
Wichita, Kansas 67202

WELL PLUGGING RECORD

SCOTT County. Sec. 20 Twp. 18S Rge. 34 (W)  
C SE NW

Location as "NE/CNW/SE/SW" or footage from lines. C SE NW  
Lease Owner J. A. ALLISON  
Lease Name GASCHLER Well No. 1  
Office Address 300 West Douglas, Suite 305, Wichita, Kansas 67202  
Character of Well (completed as Oil, Gas or Dry Hole) Dry Hole  
Date well completed November 4 19 79  
Application for plugging filed November 4 19 79  
Application for plugging approved November 7 19 79  
Plugging commenced November 4 19 79  
Plugging completed November 4 19 79  
Reason for abandonment of well or producing formation Dry Hole

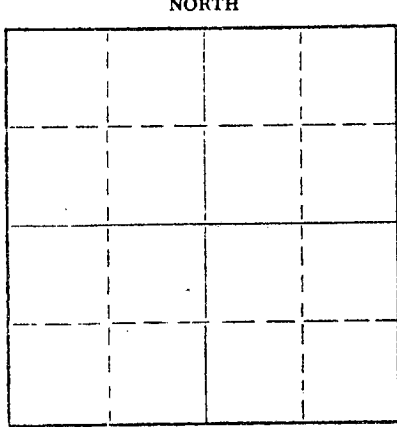

Locate well correctly on above  
Section Plat

If a producing well is abandoned, date of last production 19  
Was permission obtained from the Conservation Division or its agents before plugging was commenced? Yes

Name of Conservation Agent who supervised plugging of this well Gilbert Balthazor  
Producing formation None Depth to top Bottom Total Depth of Well 5020 Feet  
Show depth and thickness of all water, oil and gas formations.

OIL, GAS OR WATER RECORDS

CASING RECORD

FORMATION	CONTENT	FROM	TO	SIZE	PUT IN	PULLED OUT
				8-5/8"	332'	- 0 -

Describe in detail the manner in which the well was plugged, indicating where the mud fluid was placed and the method or methods used in introducing it into the hole. If cement or other plugs were used, state the character of same and depth placed, from feet to feet for each plug set.

50/50 POZ  
Spotted 70 sacks @ 900'  
20 sacks @ 300'  
10 sacks @ 40'  
5 sacks in rat hole

STATE RECEIVED  
DEC 14 1979  
CONSERVATION DIVISION  
12-14-79

(If additional description is necessary, use BACK of this sheet)  
Name of Plugging Contractor Allied Cementing Co., Inc.  
Address P. O. Box 31, Russell, Kansas 67665

STATE OF Kansas COUNTY OF Sedgwick ss.  
J. A. ALLISON (Employee or owner) or (owner or operator) of the above-described well, being first duly sworn on oath, says: That I have knowledge of the facts, statements, and matters herein contained and the log of the above-described well as filed and that the same are true and correct. So help me God.

(Signature) J. A. Allison  
300 West Douglas, #305, Wichita, Ks. 67202  
(Address)

SUBSCRIBED AND SWORN to before me this 11th day of December, 19 79

Frances O. Erhard  
Notary Public.



My commission expires

GABBERT-JONES, INC.  
 WICHITA, KANSAS  
 DRILLERS' WELL LOG

Gaschler #1  
 Sec 20-18S-34W  
 Scott County Kansas

Commenced: 10-20-79

Completed: 11-4-79

OPERATOR: J. A. Allison

Depth		Formation	Remarks
From	to		
0	340	Sand	Ran 11 jts of 24# 8 5/8" csg set @ 332' Cemented w/ 250 sks Common 3% CC PD @ 3:45 p.m. 10-20-79
340	2051	Shale-Sand	
2051	3890	Shale-Lime	
3890	3998	Lime-Shale	
3998	4123	Shale-Lime	
4123	4442	Lime-Shale	
4442	4483	Lime	
4483	4620	Lime-Shale	
4620	4706	Shale-Lime	
4706	4758	Lime-Shale	
4758	4809	Shale-Lime	
4809	4867	Lime	
4867	4912	Shale-Lime	
4912	4987	Lime-Shale	
4987	5020	Shale-Lime	
	5020 - TD		DRY & ABANDONED

STATE OF KANSAS )  
 ) SS  
 COUNTY OF SEDGWICK)

I, the undersigned, being duly sworn on oath, state that the above Drillers' Well Log is true and correct to the best of my knowledge and belief and according to the records of this office.

GABBERT-JONES, INC.

*James S. Sutton II*  
 JAMES S. SUTTON II

Subscribed and sworn to before me this 9th day of November, 1979.

*Elizabeth J. Edwards*  
 ELIZABETH J. EDWARDS-NOTARY PUBLIC

My Commission expires February 6, 1983.

