

15-171-20197-00-00

STATE OF KANSAS
STATE CORPORATION COMMISSION

Form CP-4

Give All Information Completely
Make Required Affidavit
Mail or Deliver Report to:
Conservation Division
State Corporation Commission
212 No. Market
Wichita, Kansas 67202

WELL PLUGGING RECORD

SCOTT County, Sec. 20 Twp. 18s Rge. (E) 34(W)

Location as "NE/CNW/SE/SW" or footage from lines 100' N C SE NE

Lease Owner J. A. Allison

Lease Name KRAUSE Well No. 1

Office Address 300 W. Douglas, Suite 305 Wichita, KS 67202

Character of Well (completed as Oil, Gas or Dry Hole) Dry Hole

Date well completed November 10, 1980 19

Application for plugging filed November 26, 1980 19

Application for plugging approved 19


Plugging commenced November 10, 1980 19

Plugging completed November 10, 1980 19

Reason for abandonment of well or producing formation Dry Hole

If a producing well is abandoned, date of last production -- 19

Was permission obtained from the Conservation Division or its agents before plugging was commenced? Yes

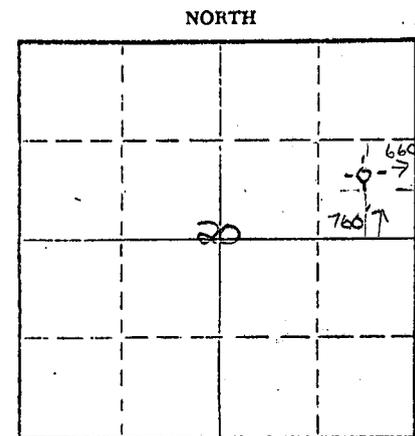

Locate well correctly on above Section Plat

Name of Conservation Agent who supervised plugging of this well Gilbert Baltazor

Producing formation _____ Depth to top _____ Bottom _____ Total Depth of Well 5012 Feet

Show depth and thickness of all water, oil and gas formations.

OIL, GAS OR WATER RECORDS

CASING RECORD

FORMATION	CONTENT	FROM	TO	SIZE	PUT IN	PULLED OUT
				8-5/8"	306'	

Describe in detail the manner in which the well was plugged, indicating where the mud fluid was placed and the method or methods used in introducing it into the hole. If cement or other plugs were used, state the character of same and depth placed, from _____ feet to _____ feet for each plug set.

70 sacks @ 920'
20 " @ 300'
10 " @ 40'
5 " @ 5'

RECEIVED
STATE CORPORATION COMMISSION
DEC - 2 1980
CONSERVATION DIVISION
Wichita, Kansas

(If additional description is necessary, use BACK of this sheet)

Name of Plugging Contractor Gabbert-Jones Inc.

Address 830 Sutton Pl. Wichita, KS 67202

STATE OF Kansas COUNTY OF Sedgwick, ss.

J. A. Allison

(employee of owner) or (owner or operator) of the above-described well, being first duly sworn on oath, says: That I have knowledge of the facts, statements, and matters herein contained and the log of the above-described well as filed and that the same are true and correct. So help me God.

(Signature)

300 W. Douglas, Suite 305 Wichita, KS

(Address)

SUBSCRIBED AND SWORN to before me this First day of December, 1980

Frances O. Erhard
Notary Public.

My commission expires January 14, 1982

