

15-171-20161-00-00

STATE OF KANSAS
STATE CORPORATION COMMISSION

WELL PLUGGING RECORD

Give All Information Completely
Make Required Affidavit
Mail or Deliver Report to:
Conservation Division
State Corporation Commission
211 No. Broadway
Wichita, Kansas


Location as "NE/CNW%SW%" or footage from lines C SW SE

Lease Owner Olympic Petroleum Company

Lease Name Leona Durr Well No. 1

Office Address 2121 S. Columbia - Tulsa, Oklahoma 74114

Character of Well (completed as Oil, Gas or Dry Hole) Dry Hole

Date well completed 8/28/78 19

Application for plugging filed 8/28/78 19

Application for plugging approved 8/28/78 19


Plugging commenced 8/28/78 19

Plugging completed 8/28/78 19

Reason for abandonment of well or producing formation Dry Hole

If a producing well is abandoned, date of last production 19

Was permission obtained from the Conservation Division or its agents before plugging was commenced? Yes

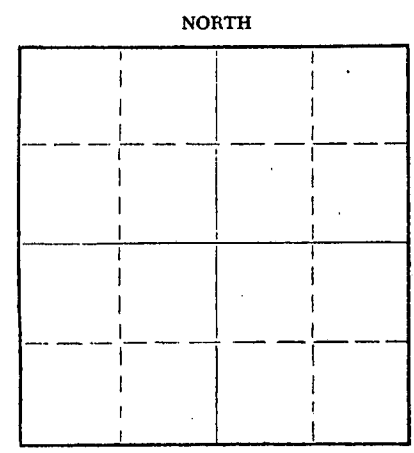

Locate well correctly on above Section Plat

Name of Conservation Agent who supervised plugging of this well Leo Massey

Producing formation Depth to top Bottom Total Depth of Well 4920 Feet

Show depth and thickness of all water, oil and gas formations.

OIL, GAS OR WATER RECORDS

CASING RECORD

FORMATION	CONTENT	FROM	TO	SIZE	PUT IN	PULLED OUT
				8 5/8"	369'	None

Describe in detail the manner in which the well was plugged, indicating where the mud fluid was placed and the method or methods used in introducing it into the hole. If cement or other plugs were used, state the character of same and depth placed, from feet to feet for each plug set.

1st Plug @ 1000' w/70 sx
2nd Plug @ 300' w/20 sx
3rd Plug @ 40' w/10 sx

RECEIVED
STATE CORPORATION COMMISSION
SEP 07 1978
CONSERVATION DIVISION
Wichita, Kansas

(If additional description is necessary, use BACK of this sheet)

Name of Plugging Contractor Thunderbird Drilling, Inc.
Address P. O. Box 18407- Wichita, Kansas 67218

STATE OF KANSAS, COUNTY OF SEDGWICK, ss.
Burke Krueger (employee of owner) or (owner or operator) of the above-described

well, being first duly sworn on oath, says: That I have knowledge of the facts, statements, and matters herein contained and the log of the above-described well as filed and that the same are true and correct. So help me God.

(Signature) Burke Krueger
P. O. Box 18407- Wichita, Kansas 67218
(Address)

SUBSCRIBED AND SWORN TO before me this 1st day of September, 1978

My commission expires 3-25-80
Gloria DeJesus
Gloria DeJesus Notary Public.



