

15-171-20107-00-00


STATE OF KANSAS  
STATE CORPORATION COMMISSION

WELL PLUGGING RECORD

Give All Information Completely  
Make Required Affidavit  
Mail or Deliver Report to  
Conservation Division  
State Corporation Comm.  
245 North Water  
Wichita, KS 67202

Scott County, Sec. 36 Twp. 19 Rge. 31W E/W  
Location as "NE/CNW<sup>1</sup>/SW<sup>1</sup>" or footage from lines  
C NE/4

Lease Owner Car-Ren, Inc.  
Lease Name Ely Well No. 1  
Office Address Suite 645, R. H. Garvey Bldg. Wichita, 67202  
Character of Well (Completed as Oil, Gas or Dry Hole) Dry Hole

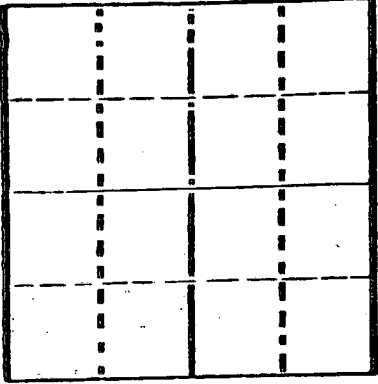

Locate well correctly on above Section Plat

Date Well completed 10/22/76 19  
Application for plugging filed 10/22/76 19  
Application for plugging approved 10/22/76 19  
Plugging commenced 10/22/76 19  
Plugging completed 10/22/76 19  
Reason for abandonment of well or producing formation

If a producing well is abandoned, date of last production 19

Was permission obtained from the Conservation Division or its agents before plugging was commenced? Yes

Name of Conservation Agent who supervised plugging of this well Gilbert Balthazor  
Producing formation Depth to top Bottom Total Depth of Well 2880  
Show depth and thickness of all water, oil and gas formations.

OIL, GAS OR WATER RECORDS

CASING RECORD

FORMATION	CONTACT	FEET	IN	SIZE	SET IN	SPALLED OUT
	Surface	0	370'	8-5/8	yes	no

Describe in detail the manner in which the well was plugged, indicating where the mud fluid was placed and the method or methods used in introducing it into the hold. If cement or other plugs were used, state the character of same and depth placed, from feet to feet for each plug set.

1st plug at 1100' with 70 sx  
2nd plug at 300' with 20 sx  
3rd plug at 40' with 10 sx  
5 sx in rat hole  
Job complete @ 5:45 on 10/22/76

RECEIVED  
STATE CORPORATION COMMISSION  
NOV 01 1976  
CONSERVATION DIVISION  
Wichita, Kansas

(If additional description is necessary, use BACK of this sheet)

Name of Plugging Contractor Slawson Drilling Company, Inc.  
408 One Twenty Building, Wichita, Kansas 67202


STATE OF Kansas COUNTY OF Sedgwick  
James C. Remsberg (employee of owner) or (owner or operator) of the above described well, being first duly sworn on oath, says: That I have knowledge of the facts, statements, and matters herein contained and the log of the above described well as filed and that the same are true and correct. So help me God.

(Signature) James C. Remsberg  
James C. Remsberg  
408 One Twenty Bldg., Wichita, Ks. 67202  
(Address)

Subscribed and sworn to before me this 28 day of October 1976

Mary Lou Taylor  
Notary Public

My commission expires January 17, 1977

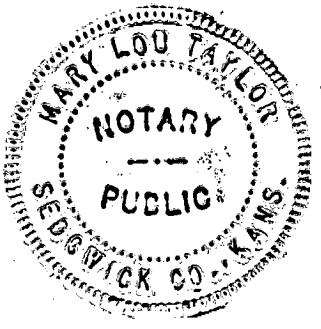

15-171-20107-00-00

DRILLERS LOG

OPERATOR: Car-Ren, Inc.  
 Suite 645, R. H. Garvey Building  
 Wichita, Kansas 67202

LEASE NAME: Ely No.1  
 C NE/4 Sec. 36-19S-32W  
 Scott County, Kansas

CONTRACTOR: Slawson Drilling Company, Inc.  
 408 One Twenty Building  
 Wichita, Kansas 67202

COMMENCED: 10/19/76

COMPLETED: 10/22/76

TOTAL DEPTH: 2880'

CASING: 362.23' of used 8-5/8" set at 370' with 275 sx cement

0' to 373' 12 1/4" Surface Hole  
 373' to 689' Shale & Shells  
 689' to 792' Shale  
 792' to 2620' Shale & Shells  
 2620' to 2790' Shale & Lime  
 2790' to 2860' Lime DST #1 2798' to 2860'  
 2860' to 2880' Lime & Shale  
 RTD 2880'

RECEIVED  
 THE CORPORATION COMMISSION  
 NOV 01 1976  
 CONSERVATION DIVISION  
 Wichita, Kansas

STATE OF KANSAS  
 COUNTY OF SEDGWICK

I, James C. Remsberg, of the Slawson Drilling Company, Inc. upon oath state that the above and foregoing is a true and correct copy of the log of the Ely No.1 well.

*James C. Remsberg*  
 James C. Remsberg

Subscribed and sworn to me on October 28, 1976

*Mary Lou Taylor*  
 Mary Lou Taylor, Notary

My commission expires January 17, 1977

