


STATE OF KANSAS  
STATE CORPORATION COMMISSION

15-171-20163-00-00

WELL PLUGGING RECORD

Give All Information Completely  
Make Required Affidavit  
Mail or Deliver Report to  
Conservation Division  
State Corporation Comm.  
245 North Water  
Wichita, KS 67202

Scott County, Sec. 8 Twp. 19 Rge. 33 E/W  
Location as "NE/CNW 1/4 SW 1/4" or footage from lines

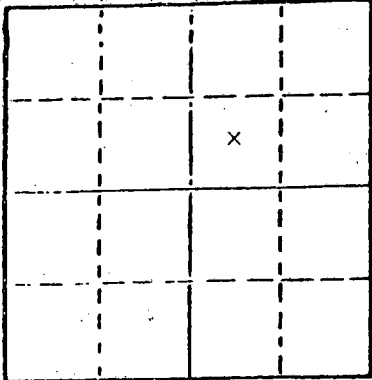

Locate well correctly on above  
Section Plot

C SW NE  
Lease Owner Continental Energy  
Lease Name Bray Well No. 1  
Office Address S. Star Route, Garden City, Kans  
Character of Well (Completed as Oil, Gas or Dry Hole)  
Dry hole  
Date Well completed 19  
Application for plugging filed 7-11 1979  
Application for plugging approved 7-12 1979  
Plugging commenced 7-13 1979  
Plugging completed 7-20 1979  
Reason for abandonment of well or producing formation

If a producing well is abandoned, date of last production 19

Was permission obtained from the Conservation Division or its agents before plugging was commenced? Yes

Name of Conservation Agent who supervised plugging of this well Mr. Thomas  
Producing formation Depth to top Bottom Total Depth of Well 4880'  
Show depth and thickness of all water, oil and gas formations.

OIL, GAS OR WATER RECORDS

CASING RECORD

FORMATION	CONTENT	FROM	TO	SIZE	PUT IN	PULLED OUT
Surface				8 5/8"	479'	0'
Production				5 1/2"	4003'	1722'

Describe in detail the manner in which the well was plugged, indicating where the mud fluid was placed and the method or methods used in introducing it into the hold. If cement or other plugs were used, state the character of same and depth placed, from feet to feet for each plug set.

Pumped 2 sacks hulls & 20 sacks cement to 3640' Pressured to 750lbs.  
Displaced to 1000'  
Spotted 30 sacks cement 1000' to 900'  
Displaced 900' to 450'  
Spotted 25 sacks cement 450' to 375'  
Displaced to 40'  
Put bridge & 10 sacks cement 40' to 0'.  
Cut off 8 5/8" 3' below ground level.

RECEIVED  
STATE CORPORATION COMMISSION

AUG 1 1979

(If additional description is necessary, use BACK of this sheet)

Name of Plugging Contractor Midwest Casing Pulling  
Box F, Sublette, Kansas 67877 Permit # 786

STATE OF KANSAS COUNTY OF HASKELL, ss.  
I Edgar J. Eves (employee of owner) or (owner or operator)  
of the above-described well, being first duly sworn on oath, says: That I have knowledge of the facts, statements, and matters herein contained and the log of the above-described well as filed and that the same are true and correct. So help me God.

(Signature) Edgar J. Eves  
Box F, Sublette, Kansas 67877  
(Address)

SUBSCRIBED AND SWORN TO before me this 20th day of July, 1979

Sandra L. Eves  
Notary Public.

My commission expires 12-6-80

