



Well Enhancement Services, LLC

(785) 625-5155

KCC Reporting Information

Date: 11-4-11

15-097-20071-00-00

Company: H+B Petroleum Corp
 Well name: Gillette #A-2
 County: Kiowa
 Casing Weight: 10.5
 Casing Size: 4 1/2 5 1/2 7
 Working String Size: 2 3/8 2 7/8


Legal SW-NE 9-30s-19W
1993 FNL & 1984 FEL

No. of Laterals 6

Jetting Fluid

KCL Water: _____
 Acid: _____ Diesel: _____

	<u>Lateral Depth</u>	<u>Lateral Direction</u>	<u>Lateral Distance</u>
I	<u>5105</u>	<u>145°</u>	<u>600'</u>
	<u>5105</u>	<u>270°</u>	<u>600'</u>
II	<u>5098</u>	<u>270°</u>	<u>600'</u>
	<u>5098</u>	<u>145°</u>	<u>450'</u>
III	_____	_____	_____
IV	<u>5080</u>	<u>285°</u>	<u>600'</u>
			<u>600'</u>
V	<u>5073</u>	<u>270°</u>	

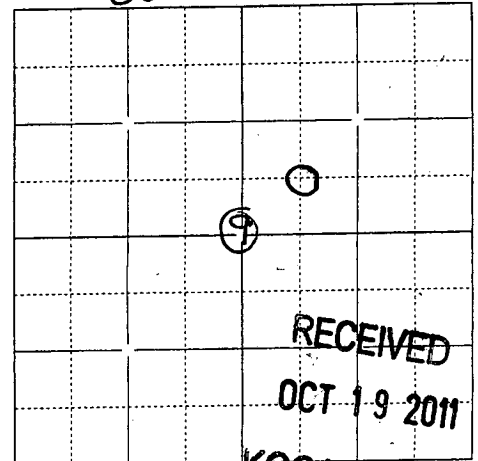

Please file one copy with: _____
 KCC _____
 Attn: Steve Bond or Production Manager _____
 130 S. Market, Rm 2078 _____
 Wichita, KS 67202 _____

RECEIVED
 OCT 19 2011
 KCC WICHITA