



Well Enhancement Services, LLC

(785) 625-5155

RECEIVED
DEC 01 2011
12-1-11
KCC WICHITA

KCC Reporting Information

Date: 11-29-11

15-051-26217-00-00

Legal 500' FWL 1570' S2
SW/4 29-12S-20W

Company: Castle Resources Inc
 Well name: Ernie Feifer #1
 County: Ellis
 Casing Weight: 14# + 15.5#
 Casing Size: 4 1/2 5 1/2 7
 Working String Size: 2 3/8 2 7/8


No. of Laterals 4

Jetting Fluid

KCL Water: _____

Acid: 1 gal per Ft Diesel: _____

<u>Lateral Depth</u>	<u>Lateral Direction</u>	<u>Lateral Distance</u>
I <u>3879</u>	<u>South</u>	<u>330'</u>
II <u>3879</u>	<u>West</u>	<u>170'</u>
III <u>3879</u>	<u>North</u>	<u>330'</u>
IV <u>3879</u>	<u>East</u>	<u>330'</u>
V _____	_____	_____

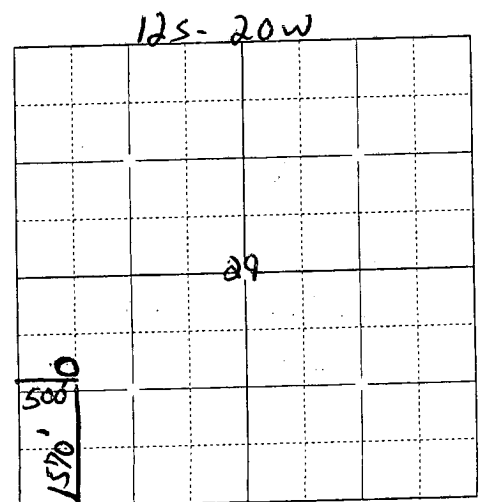

Please file one copy with:
 KCC
 Attn: Steve Bond or Production Manager
 130 S. Market, Rm 2078
 Wichita, KS 67202