

CARD MUST BE TYPED

State of Kansas
NOTICE OF INTENTION TO DRILL

CARD MUST BE SIGNED

(see rules on reverse side)

Starting Date: July 13, 1984
month day year

API Number IS- 171-20,279-00-00
 East

OPERATOR: License # 5004

C... NE 1/4 NW 1/4 Sec. 2 Twp. 19S S. Rge 31. West
(location)

Name VINCENT OIL CORPORATION

Address 125 N. Market, Suite #1110

City/State/Zip Wichita, Ks. 67202

Contact Person Ruth Benjamin

Phone (316) 262-3573

4620 Ft North from Southeast Corner of Section

3300 Ft West from Southeast Corner of Section

(Note: Locate well on Section Plat on reverse side)

CONTRACTOR: License # 5422

Name Abercrombie Drilling

City/State Wichita, Ks. 67202

Nearest lease or unit boundary line 660 feet

County Scott

Lease Name Steinberg Trust Well# 1

Domestic well within 330 feet: yes no

Municipal well within one mile: yes no

Well Drilled For: Well Class: Type Equipment:

Oil Swd Infield Mud Rotary

Gas Inj Pool Ext. Air Rotary

OWWO Expl Wildcat Cable

Depth to Bottom of fresh water 120 feet

Lowest usable water formation Dakota

Depth to Bottom of usable water 1100/1200 feet

Surface pipe by Alternate: 1 2

Surface pipe to be set 375 feet

Conductor pipe if any required n/a feet

Ground surface elevation 2926 feet MSI

This Authorization Expires 1/9/85

Approved By ~~Richard A. Hiesch~~ 7/9/84 R.

If OWWO: old well info as follows:

Operator

Well Name

Comp Date Old Total Depth

Projected Total Depth 4650 feet

Projected Formation at TD Mississippian

Expected Producing Formations

I certify that we will comply with K.S.A. 55-101, et seq., plus eventually plugging hole to K.C.C. specifications.

Date July 6, 1984 Signature of Operator or Agent

Richard A. Hiesch
Richard A. Hiesch

Vice President


20 HIGGINS 7-9-84

Must be filed with the K.C.C. five (5) days prior to commencing well
This card void if drilling not started within six (6) months of date received by K.C.C.

RECEIVED
STATE CORPORATION COMMISSION

JUL 9 1984
07-09-84
[initials]

A Regular Section of Land
1 Mile = 5,280 Ft.

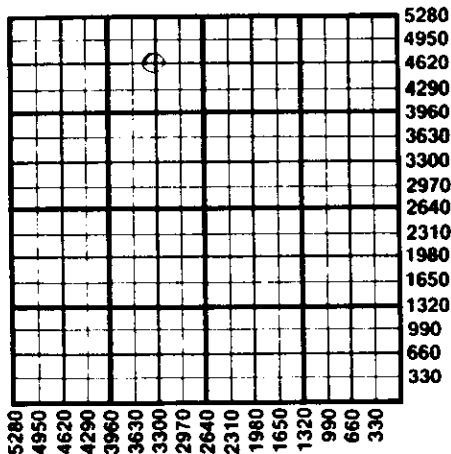

- Important procedures to follow:**
1. Notify District office before setting surface casing.
 2. Set surface casing by circulating cement to the top.
 3. File completion forms ACO-1 with K.C.C. within 90 days of well completion, following instructions on ACO-1, side 1, and including copies of wireline logs.
 4. Notify District office 48 hours prior to old well workover or re-entry.
 5. Prior to plugging, prepare a plugging plan, then obtain agreement from the appropriate district office for an approved plugging plan.
 6. Submit plugging report (CP-4) to K.C.C. after plugging is completed.
 7. Obtain an approved injection docket number before disposing of salt water.
 8. Notify K.C.C. within 10 days when injection commences or terminates.
 9. If an alternate 2 completion, cement in the production pipe from below any usable water to surface within 120 days of spud date.

State Corporation Commission of Kansas
Conservation Division
200 Colorado Derby Building
Wichita, Kansas 67202
(316) 263-3238